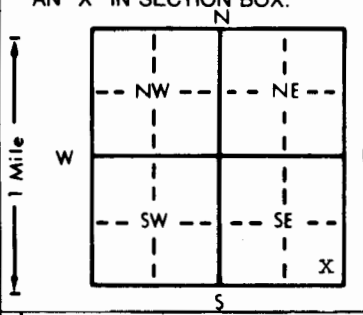


1 LOCATION OF WATER WELL: Fraction SE 1/4 SE 1/4 SE 1/4 Section Number 5 Township Number T 27 S Range Number R 7 E/W  
 County: Kingman

Distance and direction from nearest town or city street address of well if located within city?  
2 Miles North of Kingman, Kansas

2 WATER WELL OWNER: Edward W. Graber  
 RR#, St. Address, Box # : RT# 2 Board of Agriculture, Division of Water Resources  
 City, State, ZIP Code : Kingman, Kansas 67068 Application Number:

3 LOCATE WELL'S LOCATION WITH AN "X" IN SECTION BOX:  


4 DEPTH OF COMPLETED WELL: 65' ft. ELEVATION:  
 Depth(s) Groundwater Encountered 1. 8' ft. 2. 8' ft. 3. 8' ft.  
 WELL'S STATIC WATER LEVEL 8' ft. below land surface measured on mo/day/yr Aug 24 - 93  
 Pump test data: Well water was NA ft. after NA hours pumping NA gpm  
 Est. Yield NA gpm: Well water was NA ft. after NA hours pumping NA gpm  
 Bore Hole Diameter 7 7/8" to 25' ft., and 6 3/4" in. to 65' ft.  
 WELL WATER TO BE USED AS: 5 Public water supply 8 Air conditioning 11 Injection well  
 XX1 Domestic 3 Feedlot 6 Oil field water supply 9 Dewatering 12 Other (Specify below)  
 2 Irrigation 4 Industrial 7 Lawn and garden only 10 Monitoring well  
 Was a chemical/bacteriological sample submitted to Department? Yes NA No X; If yes, mo/day/yr sample was submitted  
 Water Well Disinfected? Yes XX No

5 TYPE OF BLANK CASING USED: 5 Wrought iron 8 Concrete tile CASING JOINTS: Glued X Clamped NA  
 1 Steel 3 RMP (SR) 6 Asbestos-Cement 9 Other (specify below) Welded NA  
 XX2 PVC 4 ABS 7 Fiberglass Threaded NA  
 Blank casing diameter 5" in. to 25' ft., Dia NA in. to NA ft., Dia NA in. to NA ft.  
 Casing height above land surface 16" in., weight 160 lbs./ft. Wall thickness or gauge No. Sdr 26  
 TYPE OF SCREEN OR PERFORATION MATERIAL: 7 PVC 10 Asbestos-cement  
 1 Steel 3 Stainless steel 5 Fiberglass 8 RMP (SR) 11 Other (specify) NA  
 2 Brass 4 Galvanized steel 6 Concrete tile 9 ABS XX12 None used (open hole)  
 SCREEN OR PERFORATION OPENINGS ARE: 5 Gauzed wrapped 8 Saw cut XX1 None (open hole)  
 1 Continuous slot 3 Mill slot 6 Wire wrapped 9 Drilled holes  
 2 Louvered shutter 4 Key punched 7 Torch cut 10 Other (specify) NA  
 SCREEN-PERFORATED INTERVALS: From NA ft. to NA ft., From NA ft. to NA ft.  
 From NA ft. to NA ft., From NA ft. to NA ft.  
 GRAVEL PACK INTERVALS: From None ft. to NA ft., From NA ft. to NA ft.  
 From None ft. to NA ft., From NA ft. to NA ft.

6 GROUT MATERIAL: 1 Neat cement 2 Cement grout XX3 Bentonite 4 Other  
 Grout Intervals: From 25' ft. to 4' ft., From NA ft. to NA ft., From NA ft. to NA ft.  
 What is the nearest source of possible contamination: XX10 Livestock pens 14 Abandoned water well  
 1 Septic tank 4 Lateral lines 7 Pit privy 11 Fuel storage 15 Oil well/Gas well  
 2 Sewer lines 5 Cess pool 8 Sewage lagoon 12 Fertilizer storage 16 Other (specify below)  
 3 Watertight sewer lines 6 Seepage pit 9 Feedyard 13 Insecticide storage  
 Direction from well? Northwest How many feet? 500'

FROM	TO	LITHOLOGIC LOG	FROM	TO	PLUGGING INTERVALS
0'	4'	top soil.			
4'	9'	Brown clay.			
9'	13'	Sandy clay.			
13'	16'	fine sand.			
16'	19'	white clay.			
19'	23'	Medium course sand.			
23'	25'	Red Bed.			
25'	47'	Red bed.			
47'	52'	Broken red bed.			
52'	65'	Red bed.			

7 CONTRACTOR'S OR LANDOWNER'S CERTIFICATION: This water well was (1) constructed, (2) reconstructed, or (3) plugged under my jurisdiction and was completed on (mo/day/year) Aug 23 - 93 and this record is true to the best of my knowledge and belief. Kansas Water Well Contractor's License No. 112 This Water Well Record was completed on (mo/day/yr) Sept 16 - 93 under the business name of Wells Drilling Co. by (signature) Dal Wells

INSTRUCTIONS: Use typewriter or ball point pen. PLEASE PRESS FIRMLY and PRINT clearly. Please fill in blanks, underline or circle the correct answers. Send top three copies to Kansas Department of Health and Environment, Bureau of Water, Topeka, Kansas 66620-0001. Telephone: 913-296-5545. Send one to WATER WELL OWNER and retain one for your records.