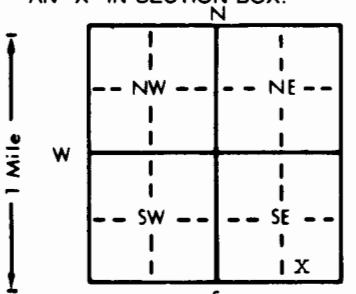


1 LOCATION OF WATER WELL: Fraction SE 1/4 SW 1/4 SE 1/4 Section Number 6 Township Number T 27 S Range Number R 7 ~~W~~  
 County: Kingman  
 Distance and direction from nearest town or city street address of well if located within city?  
 4 Miles North, 1/4 Mile West of Kingman, Kans.

2 WATER WELL OWNER: Bob Jones  
 RR#, St. Address, Box #: RT# 2 Board of Agriculture, Division of Water Resources  
 City, State, ZIP Code: Kingman, Kansas 67068 Application Number:

3 LOCATE WELL'S LOCATION WITH AN "X" IN SECTION BOX:  DEPTH OF COMPLETED WELL: 29'6" ft. ELEVATION:  
 Depth(s) Groundwater Encountered 1. 6' ft. 2. ft. 3. ft.  
 WELL'S STATIC WATER LEVEL 5' ft. below land surface measured on mo/day/yr Aug. 23-93  
 Pump test data: Well water was ft. after hours pumping gpm  
 Est. Yield NA gpm: Well water was ft. after hours pumping gpm  
 Bore Hole Diameter in. to ft., and in. to ft.  
 WELL WATER TO BE USED AS: 5 Public water supply 8 Air conditioning 11 Injection well  
 XX Domestic 3 Feedlot 6 Oil field water supply 9 Dewatering 12 Other (Specify below)  
 2 Irrigation 4 Industrial 7 Lawn and garden only 10 Monitoring well  
 Was a chemical/bacteriological sample submitted to Department? Yes No X; If yes, mo/day/yr sample was submitted  
 Water Well Disinfected? Yes X No

5 TYPE OF BLANK CASING USED: 5 Wrought iron 8 Concrete tile CASING JOINTS: Glued XX Clamped  
 1 Steel 3 RMP (SR) 6 Asbestos-Cement 9 Other (specify below) Welded  
 XX 2 PVC 4 ABS 7 Fiberglass Threaded  
 Blank casing diameter 5" in. to ft., Dia in. to ft., Dia in. to ft.  
 Casing height above land surface 14" in., weight 160 lbs./ft. Wall thickness or gauge No. Sdr 26  
 TYPE OF SCREEN OR PERFORATION MATERIAL: XX PVC 10 Asbestos-cement  
 1 Steel 3 Stainless steel 5 Fiberglass 8 RMP (SR) 11 Other (specify)  
 2 Brass 4 Galvanized steel 6 Concrete tile 9 ABS 12 None used (open hole)  
 SCREEN OR PERFORATION OPENINGS ARE: 5 Gauzed wrapped XX 8 Saw cut 11 None (open hole)  
 1 Continuous slot 3 Mill slot 6 Wire wrapped 9 Drilled holes  
 2 Louvered shutter 4 Key punched 7 Torch cut 10 Other (specify)  
 SCREEN-PERFORATED INTERVALS: From 29' ft. to 23' ft., From ft. to ft.  
 From ft. to ft., From ft. to ft.  
 GRAVEL PACK INTERVALS: From ft. to ft., From ft. to ft.  
 From 29'6" ft. to 23'6" ft., From ft. to ft.

6 GROUT MATERIAL: 1 Neat cement 2 Cement grout XX3 Bentonite 4 Other  
 Grout Intervals: From 23'6" ft. to 3' ft., From ft. to ft., From ft. to ft.  
 What is the nearest source of possible contamination: XX0 Livestock pens 14 Abandoned water well  
 1 Septic tank 4 Lateral lines 7 Pit privy 11 Fuel storage 15 Oil well/Gas well  
 2 Sewer lines 5 Cess pool 8 Sewage lagoon 12 Fertilizer storage 16 Other (specify below)  
 3 Watertight sewer lines 6 Seepage pit 9 Feedyard 13 Insecticide storage  
 Direction from well? West How many feet? 120'

FROM	TO	LITHOLOGIC LOG	FROM	TO	PLUGGING INTERVALS
0'	3'	Sandy top soil.			
3'	11'	Clay.			
11'	16'	fine sand.			
16'	19'	white sandy clay.			
19'	22'	White sandy clay.			
22'	29'	Course sand (clean)			
29'	29'6"	Red bed.			

7 CONTRACTOR'S OR LANDOWNER'S CERTIFICATION: This water well was (1) constructed, (2) reconstructed, or (3) plugged under my jurisdiction and was completed on (mo/day/year) Aug. 23-93 and this record is true to the best of my knowledge and belief. Kansas Water Well Contractor's License No. 112 This Water Well Record was completed on (mo/day/yr) Sept. 17-93 under the business name of Wells drilling Co. by (signature) Dal Wells