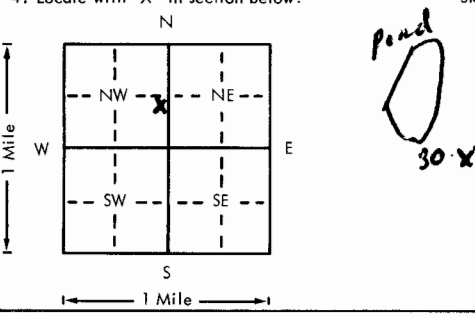


USE TYPEWRITER OR BALL
POINT PEN-PRESS FIRMLY,
PRINT CLEARLY.

WATER WELL RECORD
KSA 82a-1201-1215

Kansas Department of Health and
Environment-Division of Environment
(Water well Contractors)
Topeka, Kansas 66620

1. Location of well:		County Kingman	Fraction NE 1/4 SE 1/4 NW 1/4	Section number 13	Township number T 27 S R 7 E	Range number 7
2. Distance and direction from nearest town or city: 3 mi. E, 2 1/2 mi. N		3. Owner of well: Elmer Rollmann R.R. or street: RT 2 City, state, zip code: Kingman, KS 67068				
4. Locate with "X" in section below:		Sketch map:				
						
5. Type and color of material		From	To	6. Bore hole dia. <u>See Note</u> in. Completion date <u>4-18-79</u> Well depth <u>170</u> ft.		
Reddish top soil		0	1	7. <input checked="" type="checkbox"/> Cable tool <input checked="" type="checkbox"/> Rotary <input type="checkbox"/> Driven <input type="checkbox"/> Dug <input type="checkbox"/> Hollow rod <input type="checkbox"/> Jetted <input type="checkbox"/> Bored <input type="checkbox"/> Reverse rotary		
Red & Blue Shale		1	170	8. Use: <input type="checkbox"/> Domestic <input type="checkbox"/> Public supply <input type="checkbox"/> Industry <input type="checkbox"/> Irrigation <input type="checkbox"/> Air conditioning <input checked="" type="checkbox"/> Stock <input type="checkbox"/> Lawn <input type="checkbox"/> Oil field water <input type="checkbox"/> Other		
				9. Casing: Material <u>Pipe</u> Height: <u>Above</u> or below Threaded <input type="checkbox"/> Welded <input type="checkbox"/> Surface <u>12</u> in. RMP <input checked="" type="checkbox"/> PVC <input type="checkbox"/> Weight <u>195</u> lbs./ft. Dia. <u>6</u> in. to <u>12</u> ft. depth Wall Thickness: inches or Dia. <u> </u> in. to <u> </u> ft. depth gage No. <u>200</u>		
				10. Screen: Manufacturer's name <u>None Used</u> Type <u> </u> Dia. <u> </u> Slot/gauze <u> </u> Length <u> </u> Set between <u> </u> ft. and <u> </u> ft. <u> </u> ft. and <u> </u> ft. Gravel pack? <u> </u> Size range of material <u> </u>		
				11. Static water level: <u>40</u> ft. below land surface Date <u> </u> mo./day/yr.		
				12. Pumping level below land surfaces: <u>100</u> ft. after <u>1</u> hrs. pumping <u>2</u> g.p.m. <u> </u> ft. after <u> </u> hrs. pumping <u> </u> g.p.m. Estimated maximum yield <u>2</u> g.p.m.		
				13. Water sample submitted: <u> </u> mo./day/yr. <u> </u> Yes <input checked="" type="checkbox"/> No <u> </u> Date <u> </u>		
				14. Well head completion: <u> </u> Pitless adapter <u>12</u> inches above grade		
				15. Well grouted? <u>Yes</u> With: <input checked="" type="checkbox"/> Neat cement <input checked="" type="checkbox"/> Bentonite <u> </u> Concrete <u> </u> Depth: From <u>2</u> ft. to <u>12</u> ft.		
				16. Nearest source of possible contamination: ft. <u>30</u> Direction <u>NW</u> Type <u>Pond</u> Well disinfected upon completion? <input checked="" type="checkbox"/> Yes <u> </u> No <u> </u>		
				17. Pump: <input checked="" type="checkbox"/> Not installed Manufacturer's name <u> </u> Model number <u> </u> HP <u> </u> Volts <u> </u> Length of drop pipe <u> </u> ft. capacity <u> </u> g.p.m. Type: <u> </u> Submersible <u> </u> Turbine <u> </u> Jet <u> </u> Reciprocating <u> </u> Centrifugal <u> </u> Other		
		(Use a second sheet if needed)				
18. Elevation:	19. Remarks:		20. Water well contractor's certification:			
Topography: <input type="checkbox"/> Hill <input checked="" type="checkbox"/> Slope <input type="checkbox"/> Upland <input type="checkbox"/> Valley	10" to 12' 5' From 12 to 170		This well was drilled under my jurisdiction and this report is true to the best of my knowledge and belief. Miller Water Well 137 Business name <u>Hatchinson, KS</u> License No. <u> </u> Address <u>Egan Mills</u> Signed <u>Egan Mills</u> Date <u>5-17-79</u> Authorized representative			

Forward the white, blue and pink copies to the Department of Health and Environment

Form WWC-5