


1 LOCATION OF WATER WELL: Fraction SW 1/4 NW 1/4 NW 1/4 Section Number 31 Township Number T 27 S Range Number R 7 ~~W~~

Distance and direction from nearest town or city street address of well if located within city?
1 1/2 mi. West 3/4 mi north of Kingman, Kans.

2 WATER WELL OWNER: Ralph Lankton
 RR#, St. Address, Box #: RT#1 - Box 157-2
 City, State, ZIP Code: Kingman, Kans. 67968
 Board of Agriculture, Division of Water Resources
 Application Number:

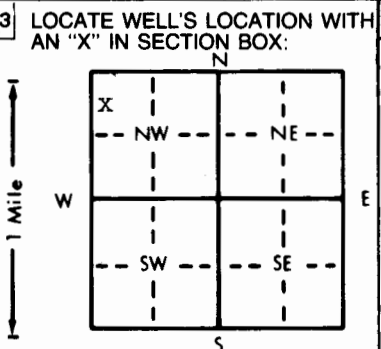

4 DEPTH OF COMPLETED WELL: 41' ft. ELEVATION: ft.
 Depth(s) Groundwater Encountered 1. 16' ft. 2. ft. 3. ft.
 WELL'S STATIC WATER LEVEL: 15' ft. below land surface measured on mo/day/yr MAR 17 - 94
 Pump test data: Well water was NA ft. after hours pumping gpm
 Est. Yield 25 gpm: Well water was ft. after hours pumping gpm
 Bore Hole Diameter: 7.7/8 in. to ft., and in. to ft.
 WELL WATER TO BE USED AS:
 Public water supply Air conditioning Injection well
 Domestic Feedlot Oil field water supply Dewatering Other (Specify below)
 Irrigation Industrial Lawn and garden only Monitoring well
 Was a chemical/bacteriological sample submitted to Department? Yes.....No..........; If yes, mo/day/yr sample was submitted
 Water Well Disinfected? Yes No

5 TYPE OF BLANK CASING USED:
 1 Steel 3 RMP (SR) 5 Wrought iron 8 Concrete tile CASING JOINTS: Glued Clamped
 PVC 4 ABS 7 Fiberglass Welded
 Blank casing diameter 5 in. to 31' ft., Dia. in. to ft., Dia. in. to ft.
 Casing height above land surface 15" in., weight 160 lbs./ft. Wall thickness or gauge No. SDR 26
 TYPE OF SCREEN OR PERFORATION MATERIAL: PVC 10 Asbestos-cement
 1 Steel 3 Stainless steel 5 Fiberglass 8 RMP (SR) 11 Other (specify)
 2 Brass 4 Galvanized steel 6 Concrete tile 9 ABS 12 None used (open hole)
 SCREEN OR PERFORATION OPENINGS ARE:
 1 Continuous slot 3 Mill slot 5 Gauzed wrapped 8 Saw cut 11 None (open hole)
 2 Louvered shutter 4 Key punched 7 Torch cut 9 Drilled holes
 SCREEN-PERFORATED INTERVALS: From 41' ft. to 31' ft., From ft. to ft.
 From ft. to ft., From ft. to ft.
 GRAVEL PACK INTERVALS: From ft. to ft., From ft. to ft.
 From 41' ft. to 28' ft., From 25' ft. to 19'6" ft.

6 GROUT MATERIAL: 1 Neat cement 2 Cement grout 3 Bentonite 4 Other
 Grout Intervals: From 28' ft. to 25' ft., From 19'6" ft. to 0' ft., From ft. to ft.
 What is the nearest source of possible contamination:
 Septic tank 4 Lateral lines 7 Pit privy 10 Livestock pens 14 Abandoned water well
 Sewer lines 5 Cess pool 8 Sewage lagoon 11 Fuel storage 15 Oil well/Gas well
 Watertight sewer lines 6 Seepage pit 9 Feedyard 12 Fertilizer storage 16 Other (specify below)
 13 Insecticide storage
 Direction from well? SE How many feet? App. 200'

FROM	TO	LITHOLOGIC LOG	FROM	TO	PLUGGING INTERVALS
0'	4'	Top soil.			
4'	14'	Sandy Clay.			
14'	16'	Course sand.			
16'	22'	Clay.			
22'	28'	White Clay.			
28'	41'	Course Sand. (Clean).			
		Red Bed.			

7 CONTRACTOR'S OR LANDOWNER'S CERTIFICATION: This water well was (1) constructed, (2) reconstructed, or (3) plugged under my jurisdiction and was completed on (mo/day/year) Mar 17 - 94 and this record is true to the best of my knowledge and belief. Kansas Water Well Contractor's License No. 112. This Water Well Record was completed on (mo/day/yr) April 6 - 94 under the business name of Wells Drilling Co. by (signature) Dal Wells