


1 LOCATION OF WATER WELL: Fraction ~~1/4~~ NE 1/4 NW NW 1/4 NW 1/4 Section Number 31 Township Number T 27 S0 S Range Number R 7 W ~~5E~~
 County: Kingman

Distance and direction from nearest town or city street address of well if located within city?
 1 North 3/4 Mi West of 54 & main Kingman, Kans

2 WATER WELL OWNER: Rita R. Faulk RT#1 Board of Agriculture, Division of Water Resources
 RR#, St. Address, Box #: Michael R. Faulk Kingman, Kansas 67068 Application Number:
 City, State, ZIP Code

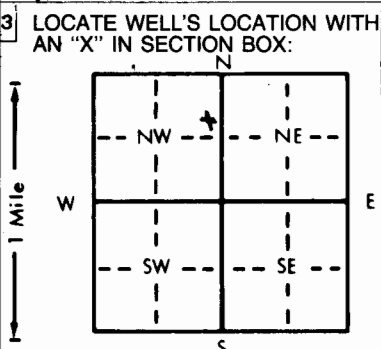

4 DEPTH OF COMPLETED WELL 56' ft. ELEVATION:
 Depth(s) Groundwater Encountered 1. 38' ft. 2. ft. 3. ft.
 WELL'S STATIC WATER LEVEL 38' ft. below land surface measured on mo/day/yr Mar 31-87
 Pump test data: Well water was NA ft. after hours pumping gpm
 Est. Yield gpm: Well water was ft. after hours pumping gpm
 Bore Hole Diameter 8 1/4" in. to 56' ft., and in. to ft.
 WELL WATER TO BE USED AS: 5 Public water supply 8 Air conditioning 11 Injection well
 1 Domestic 3 Feedlot 6 Oil field water supply 9 Dewatering 12 Other (Specify below)
 2 Irrigation 4 Industrial 7 Lawn and garden only 10 Observation well
 Was a chemical/bacteriological sample submitted to Department? Yes No ; If yes, mo/day/yr sample was submitted
 Water Well Disinfected? Yes No

5 TYPE OF BLANK CASING USED: 5 Wrought iron 8 Concrete tile CASING JOINTS: Glued Clamped
 1 Steel 3 RMP (SR) 6 Asbestos-Cement 9 Other (specify below) Welded
 2 PVC 4 ABS 7 Fiberglass Threaded
 Blank casing diameter 5" in. to 45' ft., Dia. in. to ft., Dia. in. to ft.
 Casing height above land surface 16" in., weight PVC 160 lbs./ft. Wall thickness or gauge No. SDR 26
 TYPE OF SCREEN OR PERFORATION MATERIAL: 7 PVC 10 Asbestos-cement
 1 Steel 3 Stainless steel 5 Fiberglass 8 RMP (SR) 11 Other (specify)
 2 Brass 4 Galvanized steel 6 Concrete tile 9 ABS 12 None used (open hole)
 SCREEN OR PERFORATION OPENINGS ARE: 5 Gauzed wrapped 8 Saw cut 11 None (open hole)
 1 Continuous slot 3 Mill slot 6 Wire wrapped 9 Drilled holes
 2 Louvered shutter 4 Key punched 7 Torch cut 10 Other (specify)
 SCREEN-PERFORATED INTERVALS: From 45' ft. to 56' ft., From ft. to ft.
 GRAVEL PACK INTERVALS: From ft. to ft., From ft. to ft.
 From 42' ft. to 56' ft., From ft. to ft.

6 GROUT MATERIAL: 1 Neat cement 2 Cement grout 3 Bentonite 4 Other
 Grout Intervals: From 18' ft. to 40' ft., From ft. to ft., From ft. to ft.
 What is the nearest source of possible contamination:
 1-Septic tank 4 Lateral lines 7 Pit privy 10 Livestock pens 14 Abandoned water well
 2 Sewer lines 5 Cess pool 8 Sewage lagoon 11 Fuel storage 15 Oil well/Gas well
 3 Watertight sewer lines 6 Seepage pit 9 Feedyard 12 Fertilizer storage 16 Other (specify below)
 13 Insecticide storage
 Direction from well? SW How many feet? 80'

FROM	TO	LITHOLOGIC LOG	FROM	TO	LITHOLOGIC LOG
0'	6'	Sandy top soil			
6'	11'	Sandy Clay			
11'	17'	Gray Clay			
17'	27'	Very fine sand			
27'	42'	Brown Clay			
42'	45'	Fine sand			
45'	50'	Course Sand & Fine Gravel			
50'	56'	Course sand & fine gravel			
		Red Bed			

7 CONTRACTOR'S OR LANDOWNER'S CERTIFICATION: This water well was (1) constructed, (2) reconstructed, or (3) plugged under my jurisdiction and was completed on (mo/day/year) April 8-87 and this record is true to the best of my knowledge and belief. Kansas Water Well Contractor's License No. 112 This Water Well Record was completed on (mo/day/yr) May 28-87 under the business name of Wells Drilling Co. by (signature) Dal Wells

INSTRUCTIONS: Use typewriter or ball point pen, PLEASE PRESS FIRMLY and PRINT clearly. Please fill in blanks, underline or circle the correct answers. Send top three copies to Kansas Department of Health and Environment, Division of Environment, Environmental Geology Section, Topeka, KS 66620. Send one to WATER WELL OWNER and retain one for your records.

OFFICE USE ONLY
T
R
E/W
SEC.
1/4
1/4
1/4