


1 LOCATION OF WATER WELL: Fraction NE 1/4 NW 1/4 NW 1/4 Section Number 31 Township Number T 27 S Range Number R 7 **NEW**
 County: Kingman
 Distance and direction from nearest town or city street address of well if located within city?
1 mile north 3/4 mile west 1/4 so of Kingman, Kns.

2 WATER WELL OWNER: Duane Slates
RT#1
 RR#, St. Address, Box #: Kingman, Kans 67068
 City, State, ZIP Code: Kingman, Kans 67068
 Board of Agriculture, Division of Water Resources
 Application Number:

3 LOCATE WELL'S LOCATION WITH AN "X" IN SECTION BOX: **4 DEPTH OF COMPLETED WELL:** 50' ft. ELEVATION: ft.
 Depth(s) Groundwater Encountered 17', 19' ft. 2. ft. 3. ft.
 WELL'S STATIC WATER LEVEL ft. below land surface measured on mo/day/yr April 28 89
 Pump test data: Well water was NA ft. after hours pumping gpm
 Est. Yield gpm: Well water was ft. after hours pumping gpm
 Bore Hole Diameter 8 1/4" in. to 50' ft., and in. to ft.
 WELL WATER TO BE USED AS: 5 Public water supply 8 Air conditioning 11 Injection well
XX1 Domestic 3 Feedlot 6 Oil field water supply 9 Dewatering 12 Other (Specify below)
 2 Irrigation 4 Industrial 7 Lawn and garden only 10 Monitoring well
 Was a chemical/bacteriological sample submitted to Department? Yes No; If yes, mo/day/yr sample was submitted
 Water Well Disinfected? Yes XX No

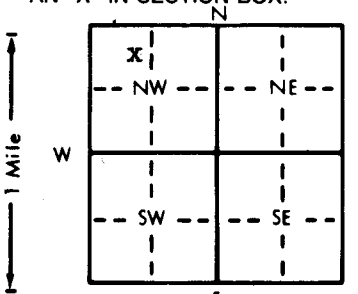

5 TYPE OF BLANK CASING USED:
 1 Steel 3 RMP (SR) 5 Wrought iron 8 Concrete tile CASING JOINTS: Glued X Clamped
 2 PVGXX 4 ABS 6 Asbestos-Cement 9 Other (specify below) Welded
 7 Fiberglass Threaded
 Blank casing diameter ... 5" in. to ... 42' ft., Dia in. to ft., Dia in. to ft.
 Casing height above land surface ... 16" in., weight ... 160 lbs./ft. Wall thickness or gauge No. SDR 26
TYPE OF SCREEN OR PERFORATION MATERIAL: XX7 PVC 10 Asbestos-cement
 1 Steel 3 Stainless steel 5 Fiberglass 8 RMP (SR) 11 Other (specify)
 2 Brass 4 Galvanized steel 6 Concrete tile 9 ABS 12 None used (open hole)
SCREEN OR PERFORATION OPENINGS ARE: 5 Gauzed wrapped XX8 Saw cut 11 None (open hole)
 1 Continuous slot 3 Mill slot 6 Wire wrapped 9 Drilled holes
 2 Louvered shutter 4 Key punched 7 Torch cut 10 Other (specify)
SCREEN-PERFORATED INTERVALS: From ... 42' ft. to ... 50' ft., From ft. to ft.
 From ft. to ft., From ft. to ft.
GRAVEL PACK INTERVALS: From ... 50' ft. to ... 22' ft., From ft. to ft.
 From ft. to ft., From ft. to ft.

6 GROUT MATERIAL: XX1 Neat cement 2 Cement grout 3 Bentonite 4 Other
 Grout Intervals: From ... 22' ft. to ... 6' ft., From ft. to ft., From ft. to ft.
 What is the nearest source of possible contamination:
XX 1 Septic tank 4 Lateral lines 7 Pit privy 11 Fuel storage 15 Oil well/Gas well
 2 Sewer lines 5 Cess pool 8 Sewage lagoon 12 Fertilizer storage 16 Other (specify below)
 3 Watertight sewer lines 6 Seepage pit 9 Feedyard 13 Insecticide storage
 Direction from well? SW How many feet? App. 112'

FROM	TO	LITHOLOGIC LOG	FROM	TO	PLUGGING INTERVALS
0'	7'	Top soil (sandy).			
7'	16'	Sandy clay.			
16'	19'	Sandy Clay.			
19'	31	Med. Fine Sand.			
31'	41'	Med. Course Sand W/Clay balls.			
41'	50'	Course Sand & Fine Gravel.			
		Red Bed.			

7 CONTRACTOR'S OR LANDOWNER'S CERTIFICATION: This water well was (1) constructed, (2) reconstructed, or (3) plugged under my jurisdiction and was completed on (mo/day/year) ... April 28 1989 and this record is true to the best of my knowledge and belief. Kansas Water Well Contractor's License No. ... 112 This Water Well Record was completed on (mo/day/yr) ... June 26 1989 under the business name of Wells Drilling Co. by (signature) Dal Wells

OFFICE USE ONLY

T

R

EW

SEC.

1/4

1/4

1/4