


1 LOCATION OF WATER WELL: Fraction NW 1/4 NW 1/4 NW 1/4 Section Number 31 Township Number T 27 S Range Number R 7 **EW**
 County: Kingman

Distance and direction from nearest town or city street address of well if located within city?
 1 Mile west 3/4 Mile north of Kingman, Kans.

2 WATER WELL OWNER: Ralph Lankton
 RR#, St. Address, Box #: RT# 1 Board of Agriculture, Division of Water Resources
 City, State, ZIP Code: Kingman, Kansas 67068 Application Number:

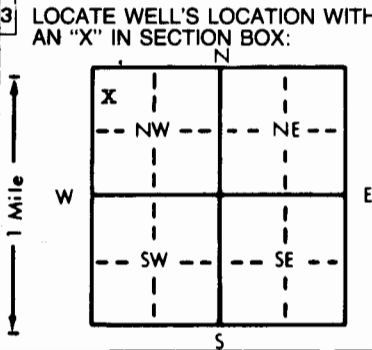

4 DEPTH OF COMPLETED WELL: 41' ft. ELEVATION:
 Depth(s) Groundwater Encountered 1. 19' ft. 2. ft. 3. ft.
 WELL'S STATIC WATER LEVEL: 14' ft. below land surface measured on mo/day/yr June 13 1989
 Pump test data: Well water was NA ft. after hours pumping gpm
 Est. Yield gpm: Well water was ft. after hours pumping gpm
 Bore Hole Diameter: 8 1/4" in. to ft., and in. to ft.
 WELL WATER TO BE USED AS:
 5 Public water supply 8 Air conditioning 11 Injection well
 1 Domestic 3 Feedlot 6 Oil field water supply 9 Dewatering 12 Other (Specify below)
 2 Irrigation 4 Industrial XX7 Lawn and garden only 10 Monitoring well
 Was a chemical/bacteriological sample submitted to Department? Yes No XX; If yes, mo/day/yr sample was submitted
 Water Well Disinfected? Yes X No

5 TYPE OF BLANK CASING USED:
 1 Steel 3 RMP (SR) 5 Wrought iron 8 Concrete tile CASING JOINTS: Glued X Clamped
 XX2 PVC 4 ABS 6 Asbestos-Cement 9 Other (specify below) Welded
 7 Fiberglass Threaded
 Blank casing diameter 5" in. to 31" ft., Dia in. to ft., Dia in. to ft.
 Casing height above land surface 14" in., weight 160 lbs./ft. Wall thickness or gauge No. SDR 26

TYPE OF SCREEN OR PERFORATION MATERIAL:
 1 Steel 3 Stainless steel 5 Fiberglass X7 PVC 10 Asbestos-cement
 2 Brass 4 Galvanized steel 6 Concrete tile 9 ABS 11 Other (specify)
 12 None used (open hole)

SCREEN OR PERFORATION OPENINGS ARE:
 1 Continuous slot 3 Mill slot 5 Gauzed wrapped XX8 Saw cut 11 None (open hole)
 2 Louvered shutter 4 Key punched 6 Wire wrapped 9 Drilled holes
 7 Torch cut 10 Other (specify)

SCREEN-PERFORATED INTERVALS: From 32' ft. to 41' ft., From ft. to ft., From ft. to ft.
 GRAVEL PACK INTERVALS: From 41' ft. to 19' ft., From ft. to ft., From ft. to ft.

6 GROUT MATERIAL: XX 1 Neat cement 2 Cement grout 3 Bentonite 4 Other
 Grout intervals: From 19' ft. to 0' ft., From ft. to ft., From ft. to ft.
 What is the nearest source of possible contamination:
 XX 1 Septic tank 4 Lateral lines 7 Pit privy 10 Livestock pens 14 Abandoned water well
 2 Sewer lines 5 Cess pool 8 Sewage lagoon 11 Fuel storage 15 Oil well/Gas well
 3 Watertight sewer lines 6 Seepage pit 9 Feedyard 12 Fertilizer storage 16 Other (specify below)
 13 Insecticide storage
 Direction from well? SE. How many feet? App: 110'

FROM	TO	LITHOLOGIC LOG	FROM	TO	PLUGGING INTERVALS
0'	4'	Top soil.			
4'	19'	Clay.			
19'	30'	Sandy clay.			
30'	41'	Course Sand & Fine Gravel.			
		Red Bed.			

7 CONTRACTOR'S OR LANDOWNER'S CERTIFICATION: This water well was (1) constructed, (2) reconstructed, or (3) plugged under my jurisdiction and was completed on (mo/day/year) June 13--1989 and this record is true to the best of my knowledge and belief. Kansas Water Well Contractor's License No. 112 This Water Well Record was completed on (mo/day/yr) June 28 1989 under the business name of Wells Drilling Co. by (signature) Dal Wells

INSTRUCTIONS: Use typewriter or ball point pen. PLEASE PRESS FIRMLY and PRINT clearly. Please fill in blanks, underline or circle the correct answers. Send top three copies to Kansas Department of Health and Environment, Bureau of Water Protection, Topeka, Kansas 66620-7320. Telephone: 913-296-5514. Send one to WATER WELL OWNER and retain one for your records.