


1 LOCATION OF WATER WELL: County: Keyman Fraction: 1/4 NW Section Number: 33 Township Number: T 27 S Range Number: R 7 E/W

Distance and direction from nearest town or city street address of well if located within city?
1 mile North of Keyman houses

2 WATER WELL OWNER: Leonel Barber Board of Agriculture, Division of Water Resources
 RR#, St. Address, Box #: Keyman Kansas 67068 Application Number:

3 LOCATE WELL'S LOCATION WITH AN "X" IN SECTION BOX:

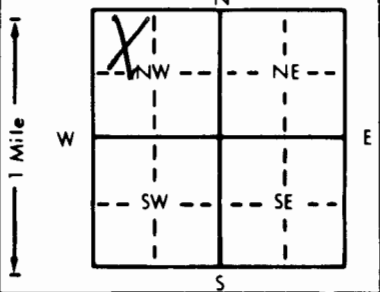

4 DEPTH OF COMPLETED WELL: 40 ft. ELEVATION:

Depth(s) Groundwater Encountered 1. 20 ft. 2. 10 ft. 3. 8 ft. 4. 92 ft.
 WELL'S STATIC WATER LEVEL 20 ft. below land surface measured on mo/day/yr
 Pump test data: Well water was _____ ft. after _____ hours pumping _____ gpm
 Est. Yield 10 gpm: Well water was _____ ft. after _____ hours pumping _____ gpm
 Bore Hole Diameter 12 in. to 40 ft., and _____ in. to _____ ft.
 WELL WATER TO BE USED AS:
 Domestic Feedlot Oil field water supply Air conditioning Injection well
 Irrigation Industrial Lawn and garden only Dewatering Other (Specify below)
 Was a chemical/bacteriological sample submitted to Department? Yes _____ No ; If yes, mo/day/yr sample was submitted
 Water Well Disinfected? Yes No _____

5 TYPE OF BLANK CASING USED:
 Steel RMP (SR) Wrought iron Concrete tile CASING JOINTS: Glued Clamped _____
 PVC ABS Asbestos-Cement Other (specify below) Welded _____
 Fiberglass Threaded _____

Blank casing diameter 5 in. to 20 ft., Dia _____ in. to _____ ft., Dia _____ in. to _____ ft.
 Casing height above land surface 2 feet in., weight _____ lbs./ft. Wall thickness or gauge No. _____

TYPE OF SCREEN OR PERFORATION MATERIAL:
 Steel Stainless steel Fiberglass PVC Asbestos-cement
 Brass Galvanized steel Concrete tile RMP (SR) Other (specify) _____
 None used (open hole)

SCREEN OR PERFORATION OPENINGS ARE:
 Continuous slot Mill slot Gauzed wrapped Saw cut None (open hole)
 Louvered shutter Key punched Wire wrapped Drilled holes
 Torch cut Other (specify) _____

SCREEN-PERFORATED INTERVALS: From 20 ft. to 40 ft., From _____ ft. to _____ ft., From _____ ft. to _____ ft.
 GRAVEL PACK INTERVALS: From 10 ft. to 30 ft., From _____ ft. to _____ ft., From _____ ft. to _____ ft.

6 GROUT MATERIAL: Neat cement Cement grout Bentonite Other _____
 Grout Intervals: From 1 ft. to 10 ft., From _____ ft. to _____ ft., From _____ ft. to _____ ft.

What is the nearest source of possible contamination:
 Septic tank Lateral lines Pit privy Livestock pens Abandoned water well
 Sewer lines Cess pool Sewage lagoon Fuel storage Oil well/Gas well
 Watertight sewer lines Seepage pit Feedyard Fertilizer storage Other (specify below)
 Insecticide storage
 Direction from well? South How many feet? 100 feet

FROM	TO	LITHOLOGIC LOG	FROM	TO	PLUGGING INTERVALS
<u>0</u>	<u>1</u>	<u>Top Soil</u>			
<u>1</u>	<u>10</u>	<u>Clay Sand</u>			
<u>20</u>	<u>30</u>	<u>Sandy Loam</u>			
<u>40</u>		<u>Red Shale</u>			
		<u>Total Well 40 feet</u>			

7 CONTRACTOR'S OR LANDOWNER'S CERTIFICATION: This water well was constructed, reconstructed, or plugged under my jurisdiction and was completed on (mo/day/year) 10 8 92 and this record is true to the best of my knowledge and belief. Kansas Water Well Contractor's License No. 226 This Water Well Record was completed on (mo/day/yr) _____ under the business name of Water Well Service by (signature) Leonel Barber