


1 LOCATION OF WATER WELL: Fraction SW 1/4 NW 1/4 NW 1/4 Section Number 18 Township Number T 27 S Range Number R 8

County: Kingman  
 Distance and direction from nearest town or city street address of well if located within city?  
4 Miles West, 3 Miles North, 2 West, 3/4 Miles North of Kingman, Kans.

2 WATER WELL OWNER: Charlie Prather  
 RR#, St. Address, Box #: 6423 Washington St. Board of Agriculture, Division of Water Resources  
 City, State, ZIP Code: Kansas City, Mo. 64113 Application Number:

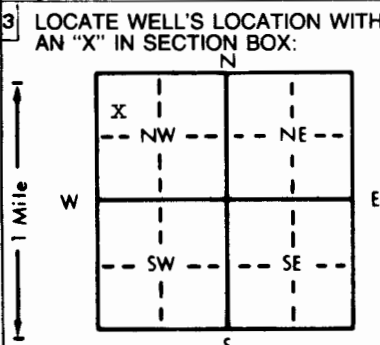

4 DEPTH OF COMPLETED WELL: 105' ft. ELEVATION: ..... ft.  
 Depth(s) Groundwater Encountered 1. 34' ft. 2. .... ft. 3. .... ft.  
 WELL'S STATIC WATER LEVEL 34' ft. below land surface measured on mo/day/yr Dec. 15 - 1995  
 Pump test data: Well water was NA ft. after ..... hours pumping ..... gpm  
 Est. Yield 30 gpm: Well water was NA ft. after ..... hours pumping ..... gpm  
 Bore Hole Diameter: 7 7/8" in. to 105" ft., and ..... in. to ..... ft.  
 WELL WATER TO BE USED AS:  
 Domestic  Feedlot  Oil field water supply  Dewatering  Other (Specify below)  
 Irrigation  Industrial  Lawn and garden only  Monitoring well  
 Was a chemical/bacteriological sample submitted to Department? Yes..... No ; If yes, mo/day/yr sample was submitted  
 Water Well Disinfected? Yes  No

5 TYPE OF BLANK CASING USED:  
 1 Steel 3 RMP (SR) 5 Wrought iron 8 Concrete tile CASING JOINTS: Glued  Clamped .....  
 XX2 PVC 4 ABS 6 Asbestos-Cement 9 Other (specify below) Welded .....  
 7 Fiberglass Threaded.....  
 Blank casing diameter 5" in. to 72" ft., Dia 5" in. to 95'-105' ft., Dia ..... in. to ..... ft.  
 Casing height above land surface 14" in., weight 160 lbs./ft. Wall thickness or gauge No. SDR 26  
 TYPE OF SCREEN OR PERFORATION MATERIAL:  
 1 Steel 3 Stainless steel 5 Fiberglass 8 RMP (SR) 10 Asbestos-cement  
 2 Brass 4 Galvanized steel 6 Concrete tile 9 ABS 12 None used (open hole)  
 SCREEN OR PERFORATION OPENINGS ARE:  
 1 Continuous slot 3 Mill slot 5 Gauzed wrapped 8 Saw cut  11 None (open hole)  
 2 Louvered shutter 4 Key punched 6 Wire wrapped 9 Drilled holes  
 7 Torch cut 10 Other (specify) .....  
 SCREEN-PERFORATED INTERVALS: From 72' ft. to 95' ft., From ..... ft. to ..... ft.  
 From ..... ft. to ..... ft., From ..... ft. to ..... ft.  
 GRAVEL PACK INTERVALS: From ..... ft. to ..... ft., From ..... ft. to ..... ft.  
 From 105' ft. to 50' ft., From 44' ft. to 23' ft.

6 GROUT MATERIAL: 1 Neat cement 2 Cement grout  Bentonite 4 Other .....  
 Grout Intervals: From 50' ft. to 44' ft., From 23' ft. to 4' ft., From ..... ft. to ..... ft.  
 What is the nearest source of possible contamination:  
 10 Livestock pens 14 Abandoned water well  
 1 Septic tank 4 Lateral lines 7 Pit privy 11 Fuel storage 15 Oil well/Gas well  
 2 Sewer lines 5 Cess pool 8 Sewage lagoon 12 Fertilizer storage 16 Other (specify below)  
 3 Watertight sewer lines 6 Seepage pit 9 Feedyard 13 Insecticide storage  
 Direction from well? 95'x East' How many feet? 95'

FROM	TO	LITHOLOGIC LOG	FROM	TO	PLUGGING INTERVALS
0'	2'	Top Soil.			
2'	6'	Fine Sand.			
6'	16'	Course Sand.			
16'	22'	Clay.			
22'	28'	Sandy Clay.			
28'	33'	Medium Course Sand W/ Clay Strips.			
33'	37'	Fine Sand.			
37'	43'	Course Sand.			
43'	50'	Clay.			
50'	70'	Fine Sand W/Clay Strips.			
70'	85'	Medium Course Sand.			
85'	95'	Medium Course Sand.			
95'	102'	Sand W/ Clay Strips.			
102'	105'	Soft Red Bed.			

7 CONTRACTOR'S OR LANDOWNER'S CERTIFICATION: This water well was (1) constructed, (2) reconstructed, or (3) plugged under my jurisdiction and was completed on (mo/day/year) Dec 15 - 1995 and this record is true to the best of my knowledge and belief. Kansas Water Well Contractor's License No. 112 This Water Well Record was completed on (mo/day/yr) Dec. 26 - 1995 under the business name of Wells Drilling Co. by (signature) Dal Wells

INSTRUCTIONS: Use typewriter or ball point pen. PLEASE PRESS FIRMLY and PRINT clearly. Please fill in blanks, underline or circle the correct answers. Send top three copies to Kansas Department of Health and Environment, Bureau of Water, Topeka, Kansas 66620-0001. Telephone: 913-296-5545. Send one to WATER WELL OWNER and retain one for your records.