


1 LOCATION OF WATER WELL: County: Kingman Fraction: NE 1/4 NE 1/4 ~~SW~~ NW 1/4 Section Number: 11 Township Number: T 27 S Range Number: R 8 ~~W~~

Distance and direction from nearest town or city street address of well if located within city?  
4 Miles North on main street; 2 3/4 West Of Kingman, Kns.

2 WATER WELL OWNER: ANN SCHLICHTING  
 RR#, St. Address, Box #: 2675 NW 50th st. Board of Agriculture, Division of Water Resources  
 City, State, ZIP Code: Kingman, Kans. 67068 Application Number:

3 LOCATE WELL'S LOCATION WITH AN "X" IN SECTION BOX:

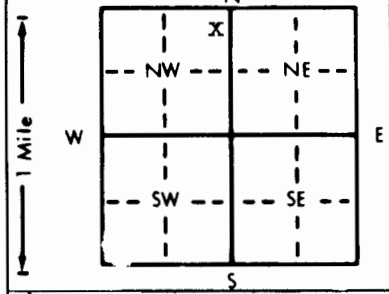

4 DEPTH OF COMPLETED WELL: 36' ft. ELEVATION:  
 Depth(s) Groundwater Encountered: 1. 12' ft. 2. ft. 3. ft.  
 WELL'S STATIC WATER LEVEL: 11 ft. below land surface measured on mo/day/yr July June 20-96  
 Pump test data: Well water was ft. after hours pumping gpm  
 Est. Yield: 18 gpm; Well water was NA ft. after hours pumping gpm  
 Bore Hole Diameter: 7 7/8" in. to 36' ft. and in. to ft.  
 WELL WATER TO BE USED AS:  
 5 Public water supply  8 Air conditioning  11 Injection well  
 2 Domestic  3 Feedlot  6 Oil field water supply  9 Dewatering  12 Other (Specify below)  
 1 Irrigation  4 Industrial  7 Lawn and garden only  10 Monitoring well  
 Was a chemical/bacteriological sample submitted to Department? Yes.....No......; If yes, mo/day/yr sample was submitted  
 Water Well Disinfected? Yes  No

5 TYPE OF BLANK CASING USED:  
 1 Steel  3 RMP (SR)  5 Wrought iron  8 Concrete tile  CASING JOINTS: Glued  Clamped  
 2 PVC  4 ABS  7 Fiberglass  Welded  
 Blank casing diameter: 5" in. to 26' ft., Dia. in. to ft., Dia. in. to ft.  
 Casing height above land surface: 14" in., weight 2.28 lbs./ft. Wall thickness or gauge No. sdr 26

TYPE OF SCREEN OR PERFORATION MATERIAL:  
 1 Steel  3 Stainless steel  5 Fiberglass  8 RMP (SR)  10 Asbestos-cement  
 2 Brass  4 Galvanized steel  6 Concrete tile  9 ABS  12 None used (open hole)

SCREEN OR PERFORATION OPENINGS ARE:  
 1 Continuous slot  3 Mill slot  5 Gauzed wrapped  8 Saw cut  11 None (open hole)  
 2 Louvered shutter  4 Key punched  7 Torch cut  9 Drilled holes

SCREEN-PERFORATED INTERVALS: From 36' ft. to 26' ft., From ft. to ft.  
 GRAVEL PACK INTERVALS: From 36' ft. to 24' ft., From ft. to ft.

6 GROUT MATERIAL:  1 Neat cement  2 Cement grout  3 Bentonite  4 Other  
 Grout Intervals: From 24' ft. to 2' ft., From ft. to ft., From ft. to ft.

What is the nearest source of possible contamination:  
 1 Septic tank  4 Lateral lines  7 Pit privy  10 Livestock pens  14 Abandoned water well  
 2 Sewer lines  5 Cess pool  8 Sewage lagoon  11 Fuel storage  15 Oil well/Gas well  
 3 Watertight sewer lines  6 Seepage pit  9 Feedyard  12 Fertilizer storage  16 Other (specify below)  
 13 Insecticide storage

Direction from well? North East How many feet? App. 200'

FROM	TO	LITHOLOGIC LOG	FROM	TO	PLUGGING INTERVALS
0'	4'	Top soil.			
4'	12'	Sandy Clay.			
12'	21'	Medium Course sand.			
21'	23'	Clay.			
23'	34'	Course sand.			
34'	36'	Red Bed.			

7 CONTRACTOR'S OR LANDOWNER'S CERTIFICATION: This water well was (1) constructed, (2) reconstructed, or (3) plugged under my jurisdiction and was completed on (mo/day/year) June 20, 1996 and this record is true to the best of my knowledge and belief. Kansas Water Well Contractor's License No. 112 This Water Well Record was completed on (mo/day/yr) July June 20 -1996 under the business name of Wells Drilling Co. by (signature) Dal Wells