


1 LOCATION OF WATER WELL: Fraction NE 1/4 SE 1/4 NE 1/4 Section Number 25 Township Number T 27 S Range Number R 8 E/W
 County: Kingman

Distance and direction from nearest town or city street address of well if located within city?
1 Mile West 1 1/2 Mile North Of Kingman, Kans.

2 WATER WELL OWNER: Richard Ellis
 RR#, St. Address, Box #: 1685 NW 10th Ave Board of Agriculture, Division of Water Resources
 City, State, ZIP Code: Kingman, Kans 67068 Application Number:

3 LOCATE WELL'S LOCATION WITH AN "X" IN SECTION BOX:

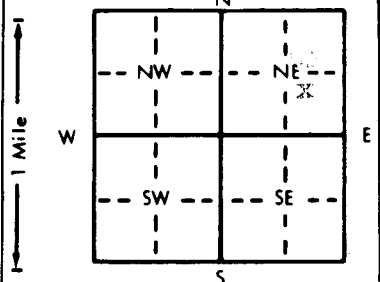

4 DEPTH OF COMPLETED WELL: 65' ft. ELEVATION:

Depth(s) Groundwater Encountered 1. 27 ft. 2. ft. 3. ft.
 WELL'S STATIC WATER LEVEL 25' ft. below land surface measured on mo/day/yr Sept. 8, 1998
 Pump test data: Well water was ft. after hours pumping gpm
 Est. Yield 25 gpm: Well water was ft. after hours pumping gpm
 Bore Hole Diameter 8 1/2" in. to 65' ft., and in. to ft.
 WELL WATER TO BE USED AS: 5 Public water supply 8 Air conditioning 11 Injection well
 Domestic 3 Feedlot 6 Oil field water supply 9 Dewatering 12 Other (Specify below)
 2 Irrigation 4 Industrial 7 Lawn and garden only 10 Monitoring well
 Was a chemical/bacteriological sample submitted to Department? Yes.....No........; If yes, mo/day/yr sample was submitted
 Water Well Disinfected? Yes No

5 TYPE OF BLANK CASING USED: 5 Wrought iron 8 Concrete tile CASING JOINTS: Glued Clamped
 1 Steel 3 RMP (SR) 6 Asbestos-Cement 9 Other (specify below) Welded
 2 PVC 4 ABS 7 Fiberglass Threaded

Blank casing diameter 5" in. to 53 ft., Dia in. to ft., Dia in. to ft.
 Casing height above land surface 14" in., weight 2.355 lbs./ft. Wall thickness or gauge No. 2, 14

TYPE OF SCREEN OR PERFORATION MATERIAL: 7 PVC 10 Asbestos-cement
 1 Steel 3 Stainless steel 5 Fiberglass 8 RMP (SR) 11 Other (specify)
 2 Brass 4 Galvanized steel 6 Concrete tile 9 ABS 12 None used (open hole)

SCREEN OR PERFORATION OPENINGS ARE: 5 Gauzed wrapped Saw cut 11 None (open hole)
 1 Continuous slot 3 Mill slot 6 Wire wrapped 9 Drilled holes
 2 Louvered shutter 4 Key punched 7 Torch cut 10 Other (specify)

SCREEN-PERFORATED INTERVALS: From 65' ft. to 53' ft., From ft. to ft.
 From ft. to ft., From ft. to ft.
 GRAVEL PACK INTERVALS: From ft. to ft., From ft. to ft.
 From 65' ft. to 25' ft., From ft. to ft.

6 GROUT MATERIAL: 1 Neat cement 2 Cement grout 3 Bentonite 4 Other
 Grout Intervals: From 25' ft. to 3" ft., From ft. to ft., From ft. to ft.

What is the nearest source of possible contamination:
 1. Septic tank 4 Lateral lines 7 Pit privy 10 Livestock pens 14 Abandoned water well
 2 Sewer lines 5 Cess pool 8 Sewage lagoon 11 Fuel storage 15 Oil well/Gas well
 3 Watertight sewer lines 6 Seepage pit 9 Feedyard 12 Fertilizer storage 16 Other (specify below)
 13 Insecticide storage

Direction from well? South East How many feet? APP: 250'

FROM	TO	LITHOLOGIC LOG	FROM	TO	PLUGGING INTERVALS
0'	2'	Top Soil.			
2'	8'	Fine Sand.			
8'	10'	Clay.			
10'	18'	Medium Fine Sand.			
18'	20'	Clay.			
20'	27'	Medium Fine Sand.			
27'	34'	Medium Course Sand.			
34'	47' 1/2	Medium Fine Sand.			
47'	62'	Course Sand.			
62'	65'	Red Bed			

7 CONTRACTOR'S OR LANDOWNER'S CERTIFICATION: This water well was (1) constructed, (2) reconstructed, or (3) plugged under my jurisdiction and was completed on (mo/day/year) Sept. 8, 1998 and this record is true to the best of my knowledge and belief. Kansas Water Well Contractor's License No. 112 This Water Well Record was completed on (mo/day/yr) Nov. 5, 1998 under the business name of Wells DRILLING CO. by (signature) Dal Wells