


USE TYPEWRITER OR BALL POINT PEN—PRESS FIRMLY, PRINT CLEARLY.

WATER WELL RECORD
KSA 82a-1201-1215

Kansas Department of Health and Environment—Division of Environment (Water well Contractors) Topeka, Kansas 66620

1. Location of well: County KING MAN Fraction SE. 1/4 NE 1/4 SE 1/4 Section number 1 Township number T 27 Range number S R 8 (EW)

2. Distance and direction from nearest town or city: 4 N 3/4 E. MIDWAY
Street address of well location if in city:
3. Owner of well Marvin Goering
R.R. or street: RR
City, state, zip code: Murdock, Kansas 67111

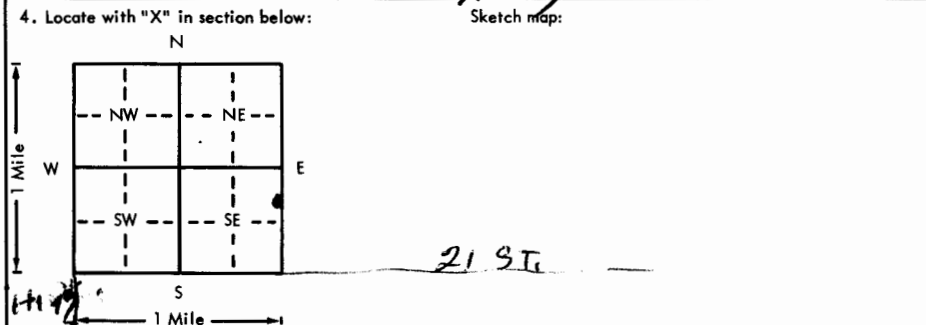

6. Bore hole dia. 2 1/8 in. Completion date April 20, 1976
Well depth 70 ft.
7. Cable tool Rotary Driven Dug
 Hollow rod Jetted Bored Reverse rotary
8. Use: Domestic Public supply Industry
 Irrigation Air conditioning Stock
 Lawn Oil field water Other
9. Casing: Material Thermit Height: Above or below
Threaded Welded Surface 12 in.
RMP PVC Weight 30 lbs./ft.
Dia. 1 1/2 in. to 44 ft. depth Wall Thickness: inches or
Dia. 1 1/2 in. to 44 ft. depth gage No. 314

5. Type and color of material	From	To
Soil	0	2
Clay	2	7
Fine sand	7	30
Fine to med. sand	30	65
Med. to coarse sand	65	70
Shale	70	71

10. Screen: Manufacturer's name Johnson
Type Sawed Dia. 1 1/2
Slot/gauze 3/16 Length 26
Set between 44 ft. and 70 ft.
ft. and 70 ft.
Gravel pack? Yes Size range of material 1/8-1/4
11. Static water level: 11 ft. below land surface Date 8/13/75 mo./day/yr.
12. Pumping level below land surfaces:
49 ft. after 1 hrs. pumping 1400 g.p.m.
44 ft. after 1/2 hrs. pumping 900 g.p.m.
Estimated maximum yield 1400 g.p.m.
13. Water sample submitted: XX Yes XX No Date _____ mo./day/yr.
14. Well head completion: 12 Pitless adapter _____ Inches above grade
15. Well grouted? Yes
With: Neat cement Bentonite Concrete
Depth: From 0 ft. to 10 ft.
16. Nearest source of possible contamination: _____ ft. _____ Direction _____ Type _____
Well disinfected upon completion? Yes No
17. Pump: _____ Not installed
Manufacturer's name Jacuzzi
Model number 4-L3 HP 6.0 Volts 470
Length of drop pipe 50 ft. capacity 800 g.p.m.
Type: Submersible Turbine
 Jet Reciprocating
 Centrifugal Other

18. Elevation: _____
19. Remarks: _____
Topography: Hill Slope Upland Valley

20. Water well contractor's certification:
This well was drilled under my jurisdiction and this report is true to the best of my knowledge and belief.
Darling Drilling Co. License No. 189
Business name _____ Address 111 West 4th, Hutchinson, Kansas
Signed Donald Darley Date 9/20/76
Authorized representative

27 SE 1/4 NE SE