


1 LOCATION OF WATER WELL: County: **Kingman** Fraction: **SE 1/4 NE 1/4 SE 1/4** Section Number: **4** Township Number: **T 27s S** Range Number: **R 8 W SW**

Distance and direction from nearest town or city street address of well if located within city?
4 Miles West - 4 1/2 Miles North of Kingman, Kans.

2 WATER WELL OWNER: **Rodney Madison**
 RR#, St. Address, Box #: **904 N Wilson**
 City, State, ZIP Code: **Ulysses, Kansas 67880**
 Board of Agriculture, Division of Water Resources
 Application Number:

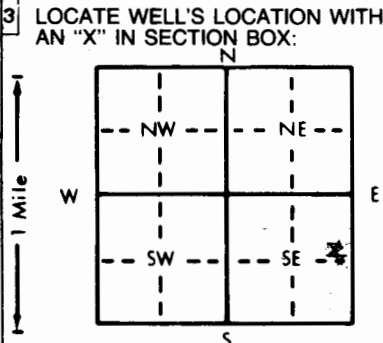

4 DEPTH OF COMPLETED WELL: **36'** ft. ELEVATION: **NA**
 Depth(s) Groundwater Encountered: 1. **16'** ft. 2. ft. 3. ft.
 WELL'S STATIC WATER LEVEL: **14'** ft. below land surface measured on **mo/day/yr Dec 15 -90**
 Pump test data: Well water was ft. after hours pumping gpm
 Est. Yield: **18** gpm; Well water was **25'** ft. after hours pumping gpm
 Bore Hole Diameter: **8 1/4** in. to **36'** ft., and in. to ft.
 WELL WATER TO BE USED AS:
 5 Public water supply 8 Air conditioning 11 Injection well
 1 Domestic 3 Feedlot 6 Oil field water supply 9 Dewatering 12 Other (Specify below)
 2 Irrigation 4 Industrial 7 Lawn and garden only 10 Monitoring well
 Was a chemical/bacteriological sample submitted to Department? Yes No X; If yes, mo/day/yr sample was submitted
 Water Well Disinfected? Yes X No

5 TYPE OF BLANK CASING USED:
 1 Steel 3 RMP (SR) 6 Asbestos-Cement 9 Other (specify below) Welded
 2 PVC 4 ABS 7 Fiberglass Threaded
 Blank casing diameter: **5** in. to **30'** ft., Dia. in. to ft., Dia. in. to ft.
 Casing height above land surface: **14"** in., weight **160** lbs./ft. Wall thickness or gauge No. **sdr 26**
 TYPE OF SCREEN OR PERFORATION MATERIAL:
 1 Steel 3 Stainless steel 5 Fiberglass 8 RMP (SR) 11 Other (specify)
 2 Brass 4 Galvanized steel 6 Concrete tile 9 ABS 12 None used (open hole)
 SCREEN OR PERFORATION OPENINGS ARE:
 1 Continuous slot 3 Mill slot 5 Gauzed wrapped 8 Saw cut 11 None (open hole)
 2 Louvered shutter 4 Key punched 6 Wire wrapped 9 Drilled holes
 7 Torch cut 10 Other (specify)
 SCREEN-PERFORATED INTERVALS: From **36'** ft. to **30'** ft., From ft. to ft.
 GRAVEL PACK INTERVALS: From ft. to ft., From ft. to ft.
 From **36'** ft. to **21** ft., From ft. to ft.

6 GROUT MATERIAL: 1 Neat cement 2 Cement grout 3 Bentonite 4 Other
 Grout Intervals: From **21'** ft. to **3'** ft., From ft. to ft., From ft. to ft.
 What is the nearest source of possible contamination:
 1 Septic tank 4 Lateral lines 7 Pit privy 10 Livestock pens 14 Abandoned water well
 2 Sewer lines 5 Cess pool 8 Sewage lagoon 11 Fuel storage 15 Oil well/Gas well
 3 Watertight sewer lines 6 Seepage pit 9 Feedyard 12 Fertilizer storage 16 Other (specify below)
 13 Insecticide storage
 Direction from well? **NW** How many feet? **About 90'**

FROM	TO	LITHOLOGIC LOG	FROM	TO	PLUGGING INTERVALS
0'	6'	Top soil.			
6'	15'	Clay w/ gravel.			
15'	22'	Clay.			
22'	36'	Course sand (clean)			
		Red bed			

7 CONTRACTOR'S OR LANDOWNER'S CERTIFICATION: This water well was (1) constructed, (2) reconstructed, or (3) plugged under my jurisdiction and was completed on (mo/day/year) **Dec 15 -90** and this record is true to the best of my knowledge and belief. Kansas Water Well Contractor's License No. **112** This Water Well Record was completed on (mo/day/yr) **Dec. 28 -90** under the business name of **Wells Drilling Co.** by (signature) *Dal Wells*