


1 LOCATION OF WATER WELL: Fraction NW 1/4 SW 1/4 NW 1/4 Section Number 6 Township Number T 27 S Range Number R 8 W E/W
 County: Kingman

Distance and direction from nearest town or city street address of well if located within city?
 5N 1W .63N 150'E of C/Int. 54 highway and Main street in Kingman, Kansas

2 WATER WELL OWNER: Lial Dodge
 RR#, St. Address, Box #: RFD 3 Board of Agriculture, Division of Water Resources
 City, State, ZIP Code: Kingman, Kansas 67068 Application Number:

3 LOCATE WELL'S LOCATION WITH AN "X" IN SECTION BOX:

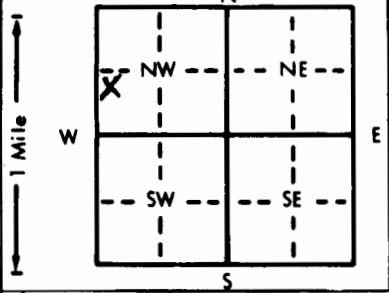

4 DEPTH OF COMPLETED WELL: 120 ft. ELEVATION:

Depth(s) Groundwater Encountered 1. 36 ft. 2. ft. 3. ft.
 WELL'S STATIC WATER LEVEL 26 ft. below land surface measured on mo/day/yr 23 May 86
 Pump test data: Well water was ft. after hours pumping gpm
 Est. Yield 10 gpm: Well water was ft. after hours pumping gpm
 Bore Hole Diameter 9 in. to 22 ft., and 7 in. to 120 ft.
 WELL WATER TO BE USED AS: 5 Public water supply 8 Air conditioning 11 Injection well
 XX Domestic 3 Feedlot 6 Oil field water supply 9 Dewatering 12 Other (Specify below)
 2 Irrigation 4 Industrial 7 Lawn and garden only 10 Observation well stock
 Was a chemical/bacteriological sample submitted to Department? Yes No X; If yes, mo/day/yr sample was submitted
 Water Well Disinfected? Yes X No

5 TYPE OF BLANK CASING USED: 5 Wrought iron 8 Concrete tile CASING JOINTS: Glued X Clamped
 1 Steel 3 RMP (SR) 6 Asbestos-Cement 9 Other (specify below) Welded
 XX 2 PVC 4 ABS 7 Fiberglass Threaded

Blank casing diameter 5 in. to 40 ft., Dia in. to ft., Dia in. to ft.
 Casing height above land surface 12 in., weight 2.34 lbs./ft. Wall thickness or gauge No. 214
 TYPE OF SCREEN OR PERFORATION MATERIAL: XX 7 PVC 10 Asbestos-cement
 1 Steel 3 Stainless steel 5 Fiberglass 8 RMP (SR) 11 Other (specify)
 2 Brass 4 Galvanized steel 6 Concrete tile 9 ABS 12 None used (open hole)

SCREEN OR PERFORATION OPENINGS ARE: 5 Gauzed wrapped XX 8 Saw cut 11 None (open hole)
 1 Continuous slot 3 Mill slot 6 Wire wrapped 9 Drilled holes
 2 Louvered shutter 4 Key punched 7 Torch cut 10 Other (specify)

SCREEN-PERFORATED INTERVALS: From 40 ft. to 120 ft., From ft. to ft.
 GRAVEL PACK INTERVALS: From none ft. to ft., From ft. to ft.
 From ft. to ft., From ft. to ft.

6 GROUT MATERIAL: 1 Neat cement XX 2 Cement grout 3 Bentonite 4 Other Puddled shale cuttings
 Grout Intervals: From 0 ft. to 10 #2 ft., From 10 ft. to 20 #4 ft., From 20 ft. to 23 #2 ft.

What is the nearest source of possible contamination:
 1 Septic tank 4 Lateral lines 7 Pit privy 10 Livestock pens 14 Abandoned water well
 2 Sewer lines 5 Cess pool 8 Sewage lagoon 11 Fuel storage 15 Oil well/Gas well
 3 Watertight sewer lines 6 Seepage pit 9 Feedyard 12 Fertilizer storage 16 Other (specify below)
 13 Insecticide storage none
 Direction from well? How many feet?

FROM	TO	LITHOLOGIC LOG	FROM	TO	LITHOLOGIC LOG
0	2	Soil, sandy			
2	9	Sand, fine			
9	17	Sand, fine to coarse			
17	36	Shale, red			
36	45	Shale, red with some small cracks			
45	79	Shale, red			
79	89	Shale, red with some small cracks			
89	97	Shale, red			
97	105	Shale, red with some small cracks			
105	120	Shale, red			

7 CONTRACTOR'S OR LANDOWNER'S CERTIFICATION: This water well was ~~10~~ constructed, (2) reconstructed, or (3) plugged under my jurisdiction and was completed on (mo/day/year) 23 May 86 and this record is true to the best of my knowledge and belief. Kansas Water Well Contractor's License No. 325 This Water Well Record was completed on (mo/day/yr) 20 June 86 under the business name of Central Well and Pump by (signature) J. Henrich