


USE TYPEWRITER OR BALL POINT PEN-PRESS FIRMLY, PRINT CLEARLY.

WATER WELL RECORD
KSA 82a-1201-1215

Kansas Department of Health and Environment-Division of Environment (Water well Contractors) Topeka, Kansas 66620

1. Location of well: County Kingman Fraction C of SE 1/4 Section number 8 Township number T 27 S R 8 E Range number 8

2. Distance and direction from nearest town or city: 6 E 3/4 S of Penalosa, Ks. Street address of well location if in city: Penalosa, Ks. 67121
3. Owner of well: Ben & Chas. Garibay R.R. or street: Penalosa, Ks. 67121 City, state, zip code: Penalosa, Ks. 67121

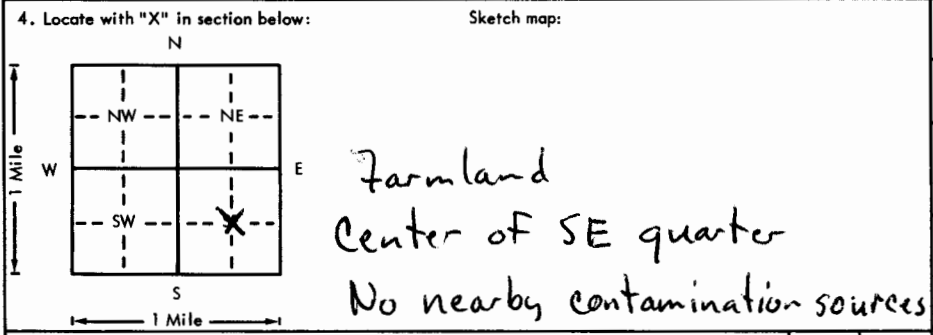

6. Bore hole dia. 9 3/4 in. Completion date Dec 16
Well depth 105 ft.
7. Cable tool Rotary Driven Dug
 Hollow rod Jetted Bored Reverse rotary
8. Use: Domestic Public supply Industry Irrigation Air conditioning Stock Lawn Oil field water Other
9. Casing: Material Plastic Height: Above or below
Threaded Welded Surface 12 in.
RMP PVC Weight 105 lbs./ft.
Dia. 5 in. to 105 ft. depth Wall Thickness: inches or
Dia. 5 in. to 105 ft. depth gage No. 200

5. Type and color of material	From	To
Topsoil	0	7
Sand F	7	12
Sand F-C & Gravel	12	15
Clay-Sand Streaks	15	48
Med Sand	48	75
Clay	75	85
Med-C Sand	85	105
Red Bed	105	-

10. Screen: Manufacturer's name Jess & Lowell
Type RMP Dia. 5"
Flow gauze 1/8" Length 45"
Set between 60 ft. and 105 ft.
Gravel pack? Size range of material 1/8-3/8 ft.
11. Static water level: 40 ft. below land surface Date 12/16/76 mg./day/yr.
12. Pumping level below land surfaces:
42 ft. after 2 hrs. pumping 8 g.p.m.
 ft. after hrs. pumping g.p.m.
Estimated maximum yield 8 g.p.m.
13. Water sample submitted: mo./day/yr.
 Yes No Date
14. Well head completion:
 Pitless adapter 12 Inches above grade
 Well grouted?
With: Neat cement Bentonite Concrete
Depth: From 2 ft. to 13 ft.
16. Nearest source of possible contamination:
ft. Direction Type
Well disinfected upon completion? Yes No
17. Pump: Not installed
Manufacturer's name Reta
Model number 709030 HP 3/4 Volts 220
Length of drop pipe ft. capacity g.p.m.
Type:
 Submersible Turbine
 Jet Reciprocating
 Centrifugal Other

18. Elevation: 19. Remarks:
Topography:
 Hill
 Slope
 Upland
 Valley
20. Water well contractor's certification:
This well was drilled under my jurisdiction and this report is true to the best of my knowledge and belief.
Wells Drilling Co. #112
Business name 1930 E Hwy 54 License No.
Address Neen & Wallace Date 1/8/76
Signed Authorized representative

22 - SW - C of SE
 R
 Sec
 1/4 1/4 1/4