USE TYPEWRITER OR BALL POINT PEN-PRESS FIRMLY, PRINT CLEARLY.

WATER WELL RECORD
KSA 82a-1201-1215

Kansas Department of Health and Environment-Division of Environment
(Water well Contractors)
Topeka, Kansas 66620

1. Location of well: County: Kingman | Fraction: 1/4 NE 1/4 SW 1/4 | Section number: 14 | Township number: T 27 S | Range number: R 8 E/W

2. Distance and direction from nearest town or city: 2-West 3 North 3 West
Street address of well location if in city: Kingman Kansas

3. Owner of well: Hazel Hamaker
R.R. or street: RT 1, BOX 311 ZIP 98502
City, state, zip code: OLYMPIA, WASHINGTON

4. Locate with "X" in section below:

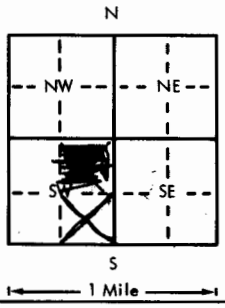

Sketch map:

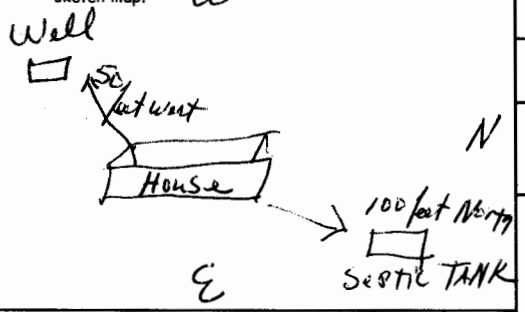

6. Bore hole dia. 8 in. Completion date 3-23-76
Well depth 46 ft.

7. ___ Cable tool X Rotary ___ Driven ___ Dug
___ Hollow rod ___ Jetted ___ Bored ___ Reverse rotary

8. Use: X Domestic ___ Public supply ___ Industry
___ Irrigation ___ Air conditioning ___ Stock
___ Lawn ___ Oil field water ___ Other

9. Casing: Material Plastic Height: Above or below
Threaded ___ Welded ___ Surface 24 in.
RMP ___ PVC X Weight ___ lbs./ft.
Dia. 5 in. to 45 ft. depth Wall Thickness: inches or
Dia. ___ in. to ___ ft. depth gage No. ___

10. Screen: Manufacturer's name Jones & Lowell
Type PVC Dia. 5
Slot/gauze 14 Length 10
Set between 35 ft. and 45 ft.
___ ft. and ___ ft.
Gravel pack? X Size range of material 14

11. Static water level: 12 ft. below land surface Date 3-23-76 (mo./day/yr.)

12. Pumping level below land surfaces:
___ ft. after ___ hrs. pumping ___ g.p.m.
___ ft. after ___ hrs. pumping ___ g.p.m.
Estimated maximum yield ___ g.p.m.

13. Water sample submitted: ___ Yes X No Date 3-23-76 (mo./day/yr.)

14. Well head completion: Well House
___ Pitless adapter 24 Inches above grade

15. Well grouted? X
With: X Neat cement ___ Bentonite ___ Concrete
Depth: From 1 ft. to 10 ft.

16. Nearest source of possible contamination:
ft. 100 Direction North Type Human
Well disinfected upon completion? ___ Yes ___ No

17. Pump: Not installed
Manufacturer's name Burks
Model number HV20 HP ½ Volts 110
Length of drop pipe 20 ft. capacity 15 g.p.m.
Type:
___ Submersible ___ Turbine
X Jet ___ Reciprocating
___ Centrifugal ___ Other

5. Type and color of material

From	To
0	1
1	10
10	20
20	30
40	46
46	

Top Soil
Sand fine Brown
Sand course Brown
Clay and Sand
Sand course Brown
Water Sand course
46 feet Total
West of Wiff-
Clay Bottom

(Use a second sheet if needed)

18. Elevation:
Topography:
___ Hill
___ Slope
X Upland
___ Valley

19. Remarks:

20. Water well contractor's certification:
This well was drilled under my jurisdiction and this report is true to the best of my knowledge and belief.
Weber Well Service 226
Business name License No.
Address Nashville Kansas
Signed Leon Weber Date 3-23-76
Authorized representative

27 T 8 R E/W 14 Sec NE 1/4 SW 1/4

Forward the white, blue and pink copies to the Department of Health and Environment.

Form WWC-5