


1 LOCATION OF WATER WELL: Fraction **SE 1/4 NW 1/4 SE 1/4** Section Number **15** Township Number **T 27s S** Range Number **R 8**

Distance and direction from nearest town or city street address of well if located within city?  
**1 North - 3 West - 1 North of Kingman, Kans**

2 WATER WELL OWNER: **Ronald Nesl Kinsler**  
 RR#, St. Address, Box #: **Spivey, Kansas 67142**  
 City, State, ZIP Code: \_\_\_\_\_  
 Board of Agriculture, Division of Water Resources  
 Application Number: **39,328**

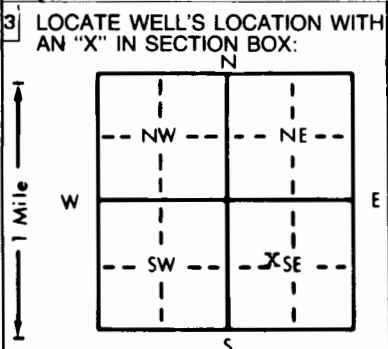

4 DEPTH OF COMPLETED WELL **53'** ft. ELEVATION: \_\_\_\_\_  
 Depth(s) Groundwater Encountered 1. **13'** ft. 2. \_\_\_\_\_ ft. 3. \_\_\_\_\_ ft.  
 WELL'S STATIC WATER LEVEL **13'** ft. below land surface measured on mo/day/yr **Nov. 12 89**  
 Pump test data: Well water was \_\_\_\_\_ ft. after \_\_\_\_\_ hours pumping \_\_\_\_\_ gpm  
 Est. Yield **NA** gpm: Well water was \_\_\_\_\_ ft. after \_\_\_\_\_ hours pumping \_\_\_\_\_ gpm  
 Bore Hole Diameter: \_\_\_\_\_ in. to \_\_\_\_\_ ft. and \_\_\_\_\_ in. to \_\_\_\_\_ ft.  
 WELL WATER TO BE USED AS: 5 Public water supply 8 Air conditioning 11 Injection well  
 1 Domestic 3 Feedlot 6 Oil field water supply 9 Dewatering 12 Other (Specify below)  
 2 Irrigation **XX** 4 Industrial 7 Lawn and garden only 10 Monitoring well  
 Was a chemical/bacteriological sample submitted to Department? Yes \_\_\_\_\_ No **X**; If yes, mo/day/yr sample was submitted \_\_\_\_\_  
 Water Well Disinfected? Yes \_\_\_\_\_ No **X**

5 TYPE OF BLANK CASING USED: 5 Wrought iron 8 Concrete tile CASING JOINTS: Glued \_\_\_\_\_ Clamped \_\_\_\_\_  
 1 Steel **XX** 3 RMP (SR) 6 Asbestos-Cement 9 Other (specify below) Welded **XX**  
 2 PVC 4 ABS 7 Fiberglass \_\_\_\_\_ Threaded \_\_\_\_\_  
 Blank casing diameter **16"** in. to **14'** ~~15'~~ ft., Dia \_\_\_\_\_ in. to \_\_\_\_\_ ft., Dia \_\_\_\_\_ in. to \_\_\_\_\_ ft.  
 Casing height above land surface **12"** in., weight **31.7** lbs./ft. Wall thickness or gauge No. **7 GA.**  
 TYPE OF SCREEN OR PERFORATION MATERIAL: 7 PVC 10 Asbestos-cement  
 1 Steel **XX** 3 Stainless steel 5 Fiberglass 8 RMP (SR) 11 Other (specify) \_\_\_\_\_  
 2 Brass 4 Galvanized steel 6 Concrete tile 9 ABS 12 None used (open hole)  
 SCREEN OR PERFORATION OPENINGS ARE: 5 Gauzed wrapped 8 Saw cut 11 None (open hole)  
 1 Continuous slot 3 Mill slot 6 Wire wrapped 9 Drilled holes  
 2 Louvered shutter 4 Key punched 7 Torch cut 10 Other (specify) **Doer Gravel Guard**  
 SCREEN-PERFORATED INTERVALS: From **14'** ft. to **53'** ft., From \_\_\_\_\_ ft. to \_\_\_\_\_ ft.  
 From \_\_\_\_\_ ft. to \_\_\_\_\_ ft., From \_\_\_\_\_ ft. to \_\_\_\_\_ ft.  
 GRAVEL PACK INTERVALS: From \_\_\_\_\_ ft. to \_\_\_\_\_ ft., From \_\_\_\_\_ ft. to \_\_\_\_\_ ft.  
 From **53'** ft. to **13'** ft., From \_\_\_\_\_ ft. to \_\_\_\_\_ ft.

6 GROUT MATERIAL: 1 Neat cement 2 Cement grout 3 Bentonite **XX** 4 Other \_\_\_\_\_  
 Grout Intervals: From \_\_\_\_\_ ft. to \_\_\_\_\_ ft., From \_\_\_\_\_ ft. to \_\_\_\_\_ ft., From \_\_\_\_\_ ft. to \_\_\_\_\_ ft.  
 What is the nearest source of possible contamination: **XXX** 10 Livestock pens 14 Abandoned water well  
 1 Septic tank 4 Lateral lines 7 Pit privy 11 Fuel storage 15 Oil well/Gas well  
 2 Sewer lines 5 Cess pool 8 Sewage lagoon 12 Fertilizer storage 16 Other (specify below)  
 3 Watertight sewer lines 6 Seepage pit 9 Feedyard 13 Insecticide storage  
 Direction from well? **1300'** **South East** How many feet? **App. 1300'**

FROM	TO	LITHOLOGIC LOG	FROM	TO	PLUGGING INTERVALS
0'	16'	Sandy top soil.			
16'	18'	Course sand & Fine gravel.			
18'	19'	Clay.			
19'	22'	Course sand & Fine Gravel (Rusty color)			
22'	23'	Rusty Brown Clay.			
23'	51'	Course sand & Fine Gravel.			
51'	53'	Red Bed.			

7 CONTRACTOR'S OR LANDOWNER'S CERTIFICATION: This water well was (1) constructed, (2) reconstructed, or (3) plugged under my jurisdiction and was completed on (mo/day/year) **Sept. 22 89** and this record is true to the best of my knowledge and belief. Kansas Water Well Contractor's License No. **112** This Water Well Record was completed on (mo/day/yr) **July 9 90** under the business name of **Wells Drilling Co.** by (signature) *D. al Wells*