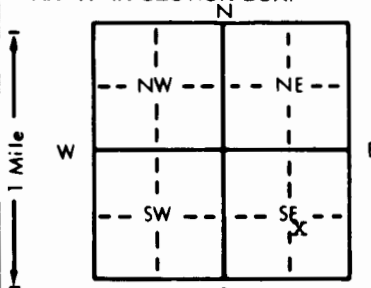


1 LOCATION OF WATER WELL: Fraction NW 1/4 SE 1/4 SE 1/4 Section Number 15 Township Number T 27s S Range Number R 8 **W**
 County: Kingman

Distance and direction from nearest town or city street address of well if located within city?
 1 north -3 west - 1 north of Kingman, Kns.

2 WATER WELL OWNER: Ronald Neal Kinsler
 RR#, St. Address, Box # : Spivey, Kans, 67142
 City, State, ZIP Code :
 Board of Agriculture, Division of Water Resources
 Application Number: 39329

3 LOCATE WELL'S LOCATION WITH AN "X" IN SECTION BOX:

 4 DEPTH OF COMPLETED WELL: 52' ft. ELEVATION:
 Depth(s) Groundwater Encountered 1. ft. 2. ft. 3. ft.
 WELL'S STATIC WATER LEVEL 13' ft. below land surface measured on mo/day/yr Aug. 12--90
 Pump test data: Well water was . ft. after . hours pumping . gpm
 Est. Yield NA gpm: Well water was . ft. after . hours pumping . gpm
 Bore Hole Diameter . in. to . ft., and . in. to . ft.
 WELL WATER TO BE USED AS: 5 Public water supply 8 Air conditioning 11 Injection well
 1 Domestic 3 Feedlot 6 Oil field water supply 9 Dewatering 12 Other (Specify below)
 2 Irrigation XX 4 Industrial 7 Lawn and garden only 10 Monitoring well
 Was a chemical/bacteriological sample submitted to Department? Yes . No. X .; If yes, mo/day/yr sample was submitted
 Water Well Disinfected? Yes No X

5 TYPE OF BLANK CASING USED:
 1 Steel XX 3 RMP (SR) 5 Wrought iron 8 Concrete tile CASING JOINTS: Glued Clamped
 2 PVC 4 ABS 6 Asbestos-Cement 9 Other (specify below) Welded XX
 7 Fiberglass Threaded
 Blank casing diameter . . . 16" . . . in. to . . . 13" . . . ft., Dia . . . in. to . . . ft., Dia . . . in. to . . . ft.
 Casing height above land surface . . . 12" . . . in., weight . . . 31.7 . . . lbs./ft. Wall thickness or gauge No. . . 7GA
 TYPE OF SCREEN OR PERFORATION MATERIAL:
 1 Steel XX 3 Stainless steel 5 Fiberglass 7 PVC 8 RMP (SR) 10 Asbestos-cement 11 Other (specify)
 2 Brass 4 Galvanized steel 6 Concrete tile 9 ABS 12 None used (open hole)
 SCREEN OR PERFORATION OPENINGS ARE:
 1 Continuous slot 3 Mill slot 5 Gauzed wrapped 8 Saw cut 11 None (open hole)
 2 Louvered shutter 4 Key punched 6 Wire wrapped 9 Drilled holes
 7 Torch cut 10 Other (specify) DOBER Gravel Guard
 SCREEN-PERFORATED INTERVALS: From . . . 53' . . . ft. to . . . 13' . . . ft., From . . . ft. to . . . ft.
 From . . . ft. to . . . ft., From . . . ft. to . . . ft.
 GRAVEL PACK INTERVALS: From . . . ft. to . . . ft., From . . . ft. to . . . ft.
 From 53' . . . ft. to 12' . . . ft., From . . . ft. to . . . ft.

6 GROUT MATERIAL: 1 Neat cement 2 Cement grout 3 Bentonite XX 4 Other
 Grout Intervals: From . . . ft. to . . . ft., From . . . ft. to . . . ft., From . . . ft. to . . . ft.
 What is the nearest source of possible contamination:
 1 Septic tank 4 Lateral lines 7 Pit privy 11 Fuel storage 14 Abandoned water well
 2 Sewer lines 5 Cess pool 8 Sewage lagoon 12 Fertilizer storage 15 Oil well/Gas well
 3 Watertight sewer lines 6 Seepage pit 9 Feedyard 13 Insecticide storage 16 Other (specify below)
 Direction from well? SO. East How many feet? 1000'

FROM	TO	LITHOLOGIC LOG	FROM	TO	PLUGGING INTERVALS
0'	3'	Sandy top soil.			
3'	11'	Brown Clay.			
11'	20'	Fine Sand.			
20'	31'	Very course sand & fine gravel.			
31'	35'	Clay.			
35'	51'	Fine gravel / Some course sand.			
51'	52'	Red bed.			

7 CONTRACTOR'S OR LANDOWNER'S CERTIFICATION: This water well was (1) constructed, (2) reconstructed, or (3) plugged under my jurisdiction and was completed on (mo/day/year) Aug 10 - 89 and this record is true to the best of my knowledge and belief. Kansas Water Well Contractor's License No. 112 This Water Well Record was completed on (mo/day/yr) July 7 90 under the business name of Wells Drilling Co. by (signature) Dal Wells