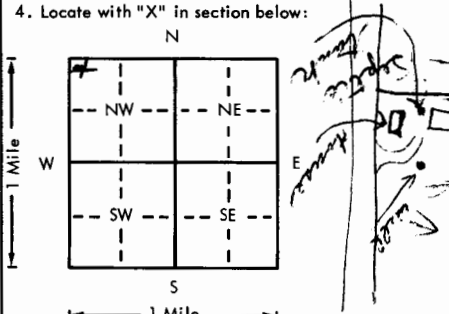


USE TYPEWRITER OR BALL POINT PEN-PRESS FIRMLY, PRINT CLEARLY.

WATER WELL RECORD
KSA 82a-1201-1215

Kansas Department of Health and Environment-Division of Environment
(Water well Contractors)
Topeka, Kansas 66620

1. Location of well: County <u>Kingman</u> Fraction <u>NW 1/4 NW 1/4 NW 1/4</u> Section number <u>16</u> Township number <u>T 27</u> Range number <u>S R 8</u> E/W	
2. Distance and direction from nearest town or city: <u>4 West 3 No 1 W 1 N of Kingman</u> Street address of well location if in city:	
3. Owner of well: <u>Steve Guesling</u> R.R. or street: <u>RR</u> City, state, zip code: <u>Kingman Kan 67068</u>	
4. Locate with "X" in section below:  Sketch map:	
5. Type and color of material	
	From To
<u>Dandy top soil</u>	<u>0' 9'</u>
<u>Brown sandy clay</u>	<u>9' 24'</u>
<u>Fines sand w/ Clay balls</u>	<u>24' 47'</u>
<u>White Clay strip</u>	<u>47' 51'</u>
<u>Fine white sand</u>	<u>51' 62'</u>
<u>Coarse sand & Fine Gravel (Clean)</u>	<u>62' 80'</u>
<u>Red Bed.</u>	
6. Bore hole dia. <u>4 1/4</u> in. Completion date <u>Feb 14 - 80</u> Well depth <u>80</u> ft.	
7. <input checked="" type="checkbox"/> Cable tool <input checked="" type="checkbox"/> Rotary <input type="checkbox"/> Driven <input type="checkbox"/> Dug <input type="checkbox"/> Hollow rod <input type="checkbox"/> Jetted <input type="checkbox"/> Bored <input type="checkbox"/> Reverse rotary	
8. Use: <input checked="" type="checkbox"/> Domestic <input type="checkbox"/> Public supply <input type="checkbox"/> Industry <input type="checkbox"/> Irrigation <input type="checkbox"/> Air conditioning <input type="checkbox"/> Stock <input type="checkbox"/> Lawn <input type="checkbox"/> Oil field water <input type="checkbox"/> Other	
9. Casing: Material <u>PITS</u> Height: Above <u>ground</u> Threaded <input type="checkbox"/> Welded <input type="checkbox"/> Surface <u>1 1/2</u> in. RMP <input checked="" type="checkbox"/> PVC <input type="checkbox"/> Weight <u>10</u> lbs./ft. Dia. <u>5</u> in. to <u>80</u> ft. depth Wall Thickness: inches or Dia. <u>5</u> in. to <u>80</u> ft. depth gage No. <u>200th</u>	
10. Screen: Manufacturer's name <u>J & L</u> Type <u>RMP</u> Dia. <u>5</u> Slot/gauze <u>1/8</u> Length <u>10</u> Set between <u>70</u> ft. and <u>80</u> ft. ft. and <u>80</u> ft. Gravel pack? <input checked="" type="checkbox"/> Size range of material <u>1/8 x 3/8</u>	
11. Static water level: <u>26</u> ft. below land surface Date <u>Feb 14 - 80</u> mo./day/yr.	
12. Pumping level below land surfaces: <u>NA</u> ft. after <u>NA</u> hrs. pumping <u>NA</u> g.p.m. <u>NA</u> ft. after <u>NA</u> hrs. pumping <u>NA</u> g.p.m. Estimated maximum yield <u>NA</u> g.p.m.	
13. Water sample submitted: <u>X</u> Yes <u>NA</u> No Date <u>NA</u> mo./day/yr.	
14. Well head completion: <input checked="" type="checkbox"/> Pitless adapter <u>16</u> inches above grade	
15. Well grouted? <input checked="" type="checkbox"/> <u>Concrete</u> With: <input type="checkbox"/> Neat cement <input type="checkbox"/> Bentonite <input checked="" type="checkbox"/> Concrete Depth: From <u>3</u> ft. to <u>15</u> ft.	
16. Nearest source of possible contamination: <u>Septic tank</u> ft. <u>120</u> Direction <u>N</u> Type <u>Septic tank</u> Well disinfected upon completion? <input checked="" type="checkbox"/> Yes <input type="checkbox"/> No	
17. Pump: <u>Not installed</u> Manufacturer's name <u>Star-Rite</u> Model number <u>NA</u> HP <u>1</u> Volts <u>230</u> Length of drop pipe <u>70'</u> ft. capacity <u>18</u> g.p.m. Type: <input checked="" type="checkbox"/> Submersible <input type="checkbox"/> Turbine <input type="checkbox"/> Jet <input type="checkbox"/> Reciprocating <input type="checkbox"/> Centrifugal <input type="checkbox"/> Other	
(Use a second sheet if needed)	
18. Elevation:	19. Remarks:
Topography: <input type="checkbox"/> Hill <input checked="" type="checkbox"/> Slope <input type="checkbox"/> Upland <input type="checkbox"/> Valley	
20. Water well contractor's certification: This well was drilled under my jurisdiction and this report is true to the best of my knowledge and belief. <u>Wells Drilling Co</u> License No. <u>112</u> Business name <u>Wells Drilling Co</u> Address <u>1023 N. Hwy 54 E - Kingman Kan</u> Signed <u>Del Wells</u> Date <u>Mar 24 - 80</u> Authorized representative	

T 27
 S R 8
 Sec 16
 NW 1/4 NW 1/4 NW 1/4