USE TYPEWRITER OR BALL POINT PEN-PRESS FIRMLY, PRINT CLEARLY.

WATER WELL RECORD
KSA 82a-1201-1215

Kansas Department of Health and Environment-Division of Environment
(Water well Contractors)
Topeka, Kansas 66620

1. Location of well:	County	Fraction	Section number	Township number	Range number
	Kingman	NW 1/4 NE 1/4 SW 1/4	16	T 27 S	R 8 E/W

2. Distance and direction from nearest town or city: 4 West 3 N 1 W 1/4 E. of Kingman Kans
Street address of well location if in city:

3. Owner of well: Bob G. Fairchild
R.R. or street: RFD #3
City, state, zip code: Kingman Kans 67068

4. Locate with "X" in section below:

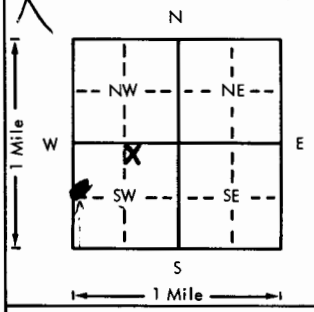

Sketch map:

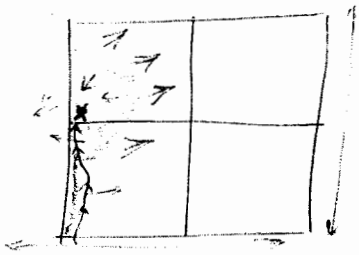

6. Bore hole dia. 28 in. Completion date
Well depth 97 ft. March 6-80

7. __ Cable tool __ Rotary __ Driven __ Dug
__ Hollow rod __ Jetted __ Bored X Reverse rotary

8. Use: __ Domestic __ Public supply __ Industry
X Irrigation __ Air conditioning __ Stock
__ Lawn __ Oil field water __ Other

9. Casing: Material Steel Height: Above or ~~Below~~
Threaded ___ Welded X Surface 18 in.
RMP ___ PVC ___ Weight ___ lbs./ft.
Dia. 16 in. to 97 ft. depth Wall Thickness: inches or
Dia. ___ in. to ___ ft. depth gage No. 7 3/16

10. Screen: Manufacturer's name W A Brown Ent.
Type Fine-Flo Dia. 16
Slot/gauze 18 Length 43'
Set between 54 ft. and 97 ft.
___ ft. and ___ ft.
Gravel pack? X Size range of material 1/8" x 3/8"

11. Static water level: mo./day/yr.
23' ft. below land surface Date 3-80

12. Pumping level below land surfaces:
___ ft. after N/A hrs. pumping ___ g.p.m.
___ ft. after ___ hrs. pumping ___ g.p.m.
Estimated maximum yield 1200 g.p.m.

13. Water sample submitted: mo./day/yr.
___ Yes X No Date

14. Well head completion:
___ Pitless adapter 18 Inches above grade

15. Well grouted? ___
With: ___ Neat cement ___ Bentonite X Concrete
Depth: From 0 ft. to 16 ft.

16. Nearest source of possible contamination:
ft. 2640 Direction N Type Septic tank
Well disinfected upon completion? ___ Yes ___ No

17. Pump: ___ Not installed
Manufacturer's name Jacuzzi
Model number 12 LSA HP 75 Volts 480
Length of drop pipe 80 ft. capacity 1000 g.p.m.
Type:
___ Submersible X Turbine
___ Jet ___ Reciprocating
___ Centrifugal ___ Other

5. Type and color of material	From	To
Sandy loam top soil	0'	9'
Red Clay	9'	23'
Course Water Sand	23'	37'
Very hard Brown Clay	37'	50'
" " White Clay	50'	53'
Course Sand w/ Fine Gravel	53'	97'
Red B.B.		

(Use a second sheet if needed)

18. Elevation:
Topography:
___ Hill
X Slope
___ Upland
___ Valley

19. Remarks: Permit # 24713

20. Water well contractor's certification:
This well was drilled under my jurisdiction and this report is true to the best of my knowledge and belief.
Wells Drlg Co 112
Business name License No.
Address 1030 Hiway 54 E. Kingman Kans
Signed Dal Wells Date Mar 24-80
Authorized representative

T 27 R 8 E/W Sec 16 1/4 1/4 1/4 NW NE SW

Forward the white, blue and pink copies to the Department of Health and Environment

Form WWC-5

MI-1023