


USE TYPEWRITER OR BALL POINT PEN-PRESS FIRMLY, PRINT CLEARLY.

WATER WELL RECORD
KSA 82a-1201-1215

Kansas Department of Health and Environment-Division of Environment (Water well Contractors) Topeka, Kansas 66620

1. Location of well: County Kingman Fraction NW 1/4 NW 1/4 NW 1/4 Section number 16 Township number T 27 S R 8 E Range number 8

2. Distance and direction from nearest town or city: 1 1/2 N - 1 W Brown's Spur
Street address of well location if in city:
3. Owner of well: Don Geesling
R.R. or street: RR #1
City, state, zip code: Kingman, Ks. 67068

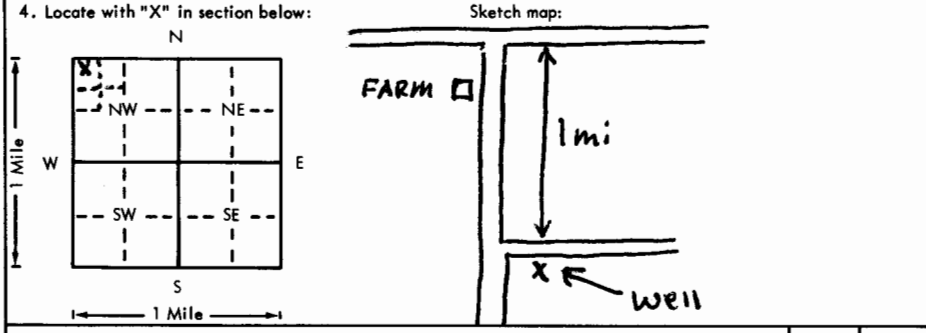

6. Bore hole dia. 28 in. Completion date 3/25/77
Well depth 87 ft.
7. Cable tool Rotary Driven Dug
 Hollow rod Jetted Bored Reverse rotary
8. Use: Domestic Public supply Industry
 Irrigation Air conditioning Stock
 Lawn Oil field water Other
9. Casing: Material Steel Height: Above or below
Threaded Welded Surface 8 in.
RMP PVC Weight lbs./ft.
Dia. 16 in. to 27 ft. depth; Wall Thickness: inches or
Dia. in. to ft. depth; gage No. 7

5. Type and color of material	From	To
<u>Sandy Top Soil</u>	<u>0</u>	<u>5</u>
<u>Brown Clay</u>	<u>5</u>	<u>28</u>
<u>Fine Sand</u>	<u>28</u>	<u>30</u>
<u>Course Sand & Gravel</u>	<u>30</u>	<u>45</u>
<u>Med Sand Clay Streaks</u>	<u>45</u>	<u>48</u>
<u>Course Sand & Gravel</u>	<u>48</u>	<u>66</u>
<u>Clay</u>	<u>66</u>	<u>81</u>
<u>Course Sand</u>	<u>81</u>	<u>87</u>
<u>Red Rock Bed</u>	<u>87</u>	<u>-</u>

10. Screen: Manufacturer's name W.A. Brown, Ent.
Type Free Flow Dia. 16 in
Slot/gauze 1/4 Length 60 Ft.
Set between ft. and ft.
Gravel pack? Size range of material 1/8 - 3/8
11. Static water level: 25 ft. below land surface Date 3/24/77
12. Pumping level below land surfaces:
45 ft. after 1 hrs. pumping 1000 g.p.m.
 ft. after hrs. pumping g.p.m.
Estimated maximum yield 1400 g.p.m.
13. Water sample submitted: Yes No Date
14. Well head completion:
 Pitless adapter 8 Inches above grade
 Well grouted?
With: Neat cement Bentonite Concrete
Depth: From 4 ft. to 16 ft.
16. Nearest source of possible contamination:
ft. 3/4 mi Direction N Type Farm
Well disinfected upon completion? Yes No
17. Pump: Not installed
Manufacturer's name Western Land Roller
Model number HP Volts
Length of drop pipe 86 ft. capacity g.p.m.
Type:
 Submersible Turbine
 Jet Reciprocating
 Centrifugal Other

18. Elevation: _____
19. Remarks: _____
Topography:
 Hill
 Slope
 Upland
 Valley

20. Water well contractor's certification:
This well was drilled under my jurisdiction and this report is true to the best of my knowledge and belief.
Wells Drilling Co. #112
Business name License No. _____
Address 1030 Hwy 54 E.
Signed Dean K. Wallace Date 3/28/77
Authorized representative

22
 R
 16
 Sec
 1/4
 1/4
 1/4
 1/4