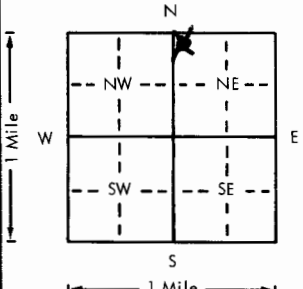


USE TYPEWRITER OR BALL POINT PEN—PRESS FIRMLY, PRINT CLEARLY.

WATER WELL RECORD
KSA 82a-1201-1215

Kansas Department of Health and Environment—Division of Environment
(Water well Contractors)
Topeka, Kansas 66620

1. Location of well:		County Kingman	Fraction NW 1/4 NW 1/4 NE 1/4	Section number 19	Township number T 27 S R 8 XW	Range number 8 XW
2. Distance and direction from nearest town or city: 6 Miles West 3 Miles North of Kingman			3. Owner of well: Sam Livingston		R.R. or street: Kingman, Kansas	
4. Locate with "X" in section below: 			Sketch map: Well No. 1 (TH 4-77)		6. Bore hole dia. 30 in. Completion date _____ Well depth 138 ft. 5/25/78	
5. Type and color of material			From	To	7. <input type="checkbox"/> Cable tool <input type="checkbox"/> Rotary <input type="checkbox"/> Driven <input type="checkbox"/> Dug <input type="checkbox"/> Hollow rod <input type="checkbox"/> Jetted <input type="checkbox"/> Bored <input checked="" type="checkbox"/> Reverse rotary	
Top soil			0	2	8. Use: <input type="checkbox"/> Domestic <input type="checkbox"/> Public supply <input type="checkbox"/> Industry <input checked="" type="checkbox"/> Irrigation <input type="checkbox"/> Air conditioning <input type="checkbox"/> Stock <input type="checkbox"/> Lawn <input type="checkbox"/> Oil field water <input type="checkbox"/> Other	
Brown clay			2	11	9. Casing: Material Steel Height: Above surface Threaded <input type="checkbox"/> Welded <input checked="" type="checkbox"/> Surface 18 in. RMP <input type="checkbox"/> PVC <input type="checkbox"/> Weight 31.75 lbs./ft. Dia. 16 in. to _____ ft. depth Wall Thickness: inches or Dia. _____ in. to _____ ft. depth Gage No. 188 "	
Med. to co. sand & gravel & tan clay			11	95	10. Screen: Manufacturer's name Doerr Metal Products Type Steel Dia. 16 " Slot/gauze _____ Length 28 ' Set between 77 ft. and 97 ft. 130 ft. and 138 ft. Gravel pack? yes Size range of material 1/8-1/4	
Tan & gray clay			95	128	11. Static water level: _____ mo./day/yr. 35 1/2 ft. below land surface Date 5/25/78	
Med. to co. sand & gravel			128	138	12. Pumping level below land surfaces: 51 ft. after 4 hrs. pumping 700 g.p.m. _____ ft. after _____ hrs. pumping _____ g.p.m. Estimated maximum yield 900 g.p.m.	
					13. Water sample submitted: _____ mo./day/yr. <input type="checkbox"/> Yes <input checked="" type="checkbox"/> No Date _____	
					14. Well head completion: <input type="checkbox"/> Pitless adapter 18 Inches above grade	
					15. Well grouted? yes With: <input type="checkbox"/> Neat cement <input type="checkbox"/> Bentonite <input checked="" type="checkbox"/> Concrete Depth: From 0 ft. to 10 ft.	
					16. Nearest source of possible contamination: ft. 1500 Direction NE Type Farm Well disinfected upon completion? <input type="checkbox"/> Yes <input checked="" type="checkbox"/> No	
					17. Pump: _____ Not installed Manufacturer's name WellLine Model number 780510 HP 50 Volts _____ Length of drop pipe 80 ft. capacity 700 g.p.m. Type: <input type="checkbox"/> Submersible <input checked="" type="checkbox"/> Turbine <input type="checkbox"/> Jet <input type="checkbox"/> Reciprocating <input type="checkbox"/> Centrifugal <input type="checkbox"/> Other	
(Use a second sheet if needed)						
18. Elevation:		19. Remarks:		20. Water well contractor's certification: This well was drilled under my jurisdiction and this report is true to the best of my knowledge and belief. Layne Western Co. 102 Business name License No. Address Wichita, Kansas Signed [Signature] Date 6/1/78 Authorized representative		
Topography: <input type="checkbox"/> Hill <input type="checkbox"/> Slope <input checked="" type="checkbox"/> Upland <input type="checkbox"/> Valley						

27 8 19
T
R
W
Sec
1/4 1/4 8 1/4
WELL LINE