


USE TYPEWRITER OR BALL POINT PEN-PRESS FIRMLY, PRINT CLEARLY.

WATER WELL RECORD
KSA 82a-1201-1215

Kansas Department of Health and Environment-Division of Environment (Water well Contractors) Topeka, Kansas 66620

1. Location of well: County KINGMAN Fraction NW 1/4 SE 1/4 SE 1/4 Section number 19 Township number T 27 S Range number R 8 W E/W

2. Distance and direction from nearest town or city: 6W 2N OF Street address of well location if in city: KINGMAN, KS
3. Owner of well: BILL PROBST R.R. or street: City, state, zip code: KINGMAN, KS

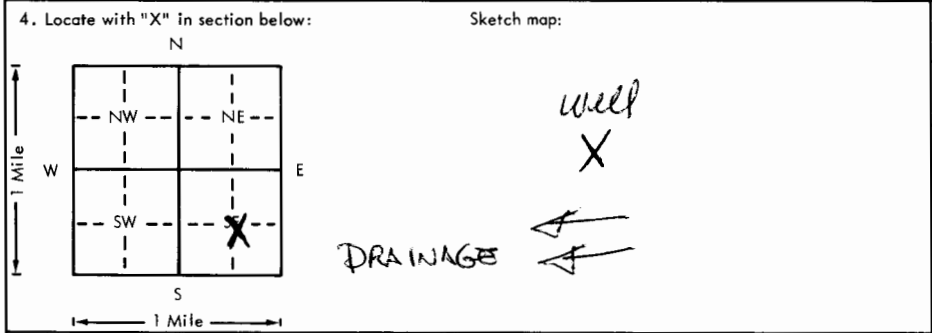

6. Bore hole dia. 30 in. Completion date 6 June 79
Well depth 115 ft.
7. Cable tool Rotary Driven Dug
 Hollow rod Jetted Bored Reverse rotary
8. Use: Domestic Public supply Industry
 Irrigation Air conditioning Stock
 Lawn Oil field water Other
9. Casing: Material STL Height Above or below
Threaded Welded Surface 12 in.
RMP PVC Weight lbs./ft.
Dia. 16 in. to 65 ft. depth Wall Thickness: inches or
Dia. in. to ft. depth gage No. 158

5. Type and color of material	From	To
<u>SOIL</u>	<u>0</u>	<u>2</u>
<u>SAND, FINE</u>	<u>2</u>	<u>6</u>
<u>SAND, FINE TO COARSE & COARSE GRAVEL</u>	<u>6</u>	<u>55</u>
<u>CLAY, TAN</u>	<u>55</u>	<u>65</u>
<u>SAND, FINE TO COARSE & MED GRAVEL</u>	<u>65</u>	<u>92</u>
<u>CLAY, TAN & RED SANDY</u>	<u>92</u>	<u>100</u>
<u>CLAY, TAN & WHITE</u>	<u>100</u>	<u>103</u>
<u>SAND, VERY FINE TO COARSE</u>	<u>103</u>	<u>108</u>
<u>SAND, FINE TO COARSE & COARSE GRAVEL</u>	<u>108</u>	<u>115</u>
<u>SHALE, RED</u>	<u>115</u>	<u>120</u>

10. Screen: Manufacturer's name WA BROWN
Type Dia. 16"
Slot/gauze 1/8 Length 50'
Set between 65 ft. and 115 ft.
 ft. and ft.
Gravel pack? Size range of material 4X3/8
11. Static water level: mo./day/yr.
40 ft. below land surface Date 6 June 79
12. Pumping level below land surfaces:
64 ft. after 1 hrs. pumping 600 g.p.m.
67.5 ft. after 1 hrs. pumping 750 g.p.m.
Estimated maximum yield 900 g.p.m.
13. Water sample submitted: mo./day/yr.
 Yes No Date _____
14. Well head completion:
 Pitless adapter 12 Inches above grade
15. Well grouted?
With: Neat cement Bentonite Concrete
Depth: From 0 ft. to 10 ft.
16. Nearest source of possible contamination: NONE
ft. _____ Direction _____ Type _____
Well disinfected upon completion? Yes No
17. Pump: Not installed
Manufacturer's name SIMMONS
Model number _____ HP 60 Volts 480
Length of drop pipe 100 ft. capacity 700 g.p.m.
Type: Submersible Turbine
 Jet Reciprocating
 Centrifugal Other

18. Elevation: Topography: Hill Slope Upland Valley
19. Remarks: 4'x4'x1' Concrete slab Paired at surface

20. Water well contractor's certification: This well was drilled under my jurisdiction and this report is true to the best of my knowledge and belief.
Central Well & Pump 325
Business name License No. _____
Address Box 1032 Pratt KS
Signed J. J. Anonich Date 20 June 79
Authorized representative