


1 LOCATION OF WATER WELL: Fraction SE 1/4 NE 1/4 NE 1/4 Section Number 21 Township Number T 27 S Range Number R 8 E 14W

County: Kingman
 Distance and direction from nearest town or city street address of well if located within city? 4 Miles West, 4 1/2 Miles North on 14 Hiway. From Kingman, Kns.

2 WATER WELL OWNER: Brown Spur CO-OP
 RR#, St. Address, Box #: RT#1 Board of Agriculture, Division of Water Resources
 City, State, ZIP Code: Kingman, Kansas 67068 Application Number:

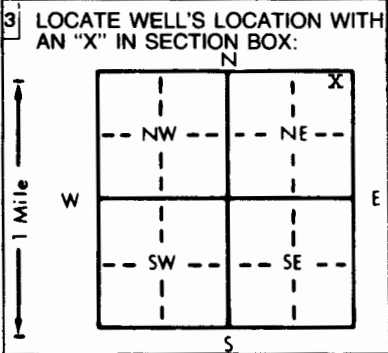

4 DEPTH OF COMPLETED WELL: 82 ft. ELEVATION: Dec-13
 Depth(s) Groundwater Encountered 1. 41' ft. 2. _____ ft. 3. _____ ft.
 WELL'S STATIC WATER LEVEL 41' ft. below land surface measured on mo/day/yr Dec 14 - 90
 Pump test data: Well water was _____ ft. after _____ hours pumping _____ gpm
 Est. Yield 20 gpm; Well water was 4 hrs ft. after _____ hours pumping _____ gpm
 Bore Hole Diameter: 8 1/2 in. to 82' ft., and _____ in. to _____ ft.
 WELL WATER TO BE USED AS:
 Domestic 3 Feedlot 6 Oil field water supply 9 Dewatering 12 Other (Specify below)
 2 Irrigation 4 Industrial 7 Lawn and garden only 10 Monitoring well
 Was a chemical/bacteriological sample submitted to Department? Yes _____ No ; If yes, mo/day/yr sample was submitted _____
 Water Well Disinfected? Yes No

5 TYPE OF BLANK CASING USED:
 1 Steel 3 RMP (SR) 5 Wrought iron 8 Concrete tile CASING JOINTS: Glued Clamped _____
 2 PVC 4 ABS 6 Asbestos-Cement 9 Other (specify below) Welded _____
 7 Fiberglass Threaded _____
 Blank casing diameter 5" in. to 70" ft., Dia _____ in. to _____ ft., Dia _____ in. to _____ ft.
 Casing height above land surface 14" in., weight 160 lbs./ft. Wall thickness or gauge No. SDR 26
 TYPE OF SCREEN OR PERFORATION MATERIAL: PVC 10 Asbestos-cement
 1 Steel 3 Stainless steel 5 Fiberglass 8 RMP (SR) 11 Other (specify) _____
 2 Brass 4 Galvanized steel 6 Concrete tile 9 ABS 12 None used (open hole)
 SCREEN OR PERFORATION OPENINGS ARE:
 5 Gauzed wrapped Saw cut 11 None (open hole)
 1 Continuous slot 3 Mill slot 6 Wire wrapped 9 Drilled holes
 2 Louvered shutter 4 Key punched 7 Torch cut 10 Other (specify) _____
 SCREEN-PERFORATED INTERVALS: From 82' ft. to 70' ft., From _____ ft. to _____ ft.
 From _____ ft. to _____ ft., From _____ ft. to _____ ft.
 GRAVEL PACK INTERVALS: From _____ ft. to _____ ft., From _____ ft. to _____ ft.
 From 82' ft. to 27' ft., From _____ ft. to _____ ft.

6 GROUT MATERIAL: 1 Neat cement 2 Cement grout Bentonite 4 Other _____
 Grout Intervals: From 27' ft. to 5' ft., From _____ ft. to _____ ft., From _____ ft. to _____ ft.
 What is the nearest source of possible contamination:
 1 Septic tank 4 Lateral lines 7 Pit privy 11 Fuel storage 14 Abandoned water well
 2 Sewer lines 5 Cess pool 8 Sewage lagoon 12 Fertilizer storage 15 Oil well/Gas well
 3 Watertight sewer lines 6 Seepage pit 9 Feedyard 13 Insecticide storage 16 Other (specify below) _____

Direction from well? East How many feet? 170' 130'

FROM	TO	LITHOLOGIC LOG	FROM	TO	PLUGGING INTERVALS
0'	12'	Top soil.			
12'	17'	Brown Clay.			
17'	27'	Brown Sandy clay.			
27'	36'	Fine sand.			
36'	40'	Grey clay			
40'	47'	White SANDY clay.			
47'	56'	Fine sand.			
56'	64'	Merium Fine Sand.			
64'	67'	White Clay.			
67'	82'	Course SAND.			
82'		Red Bed.			

7 CONTRACTOR'S OR LANDOWNER'S CERTIFICATION: This water well was (1) constructed, (2) reconstructed, or (3) plugged under my jurisdiction and was completed on (mo/day/year) Dec 13 - 90 and this record is true to the best of my knowledge and belief. Kansas Water Well Contractor's License No. 112 This Water Well Record was completed on (mo/day/yr) Dec 31 - 90 under the business name of Wells Drilling Co. by (signature) Dal Wells