


1 LOCATION OF WATER WELL: Fraction NW 1/4 SE 1/4 SW 1/4 Section Number 23 Township Number T 27 S Range Number R 8

Distance and direction from nearest town or city street address of well if located within city?
 2 miles North & 2 1/2 miles West of Kingman, KS

2 WATER WELL OWNER: J. E. McBurney
 RR#, St. Address, Box #: 703 N. Main, Box 365
 City, State, ZIP Code: Kingman, KS 67068
 Board of Agriculture, Division of Water Resources
 Application Number: Permit #39, 018

3 LOCATE WELL'S LOCATION WITH AN "X" IN SECTION BOX:

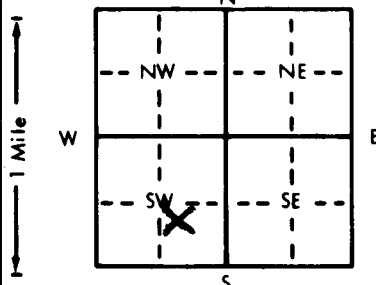

4 DEPTH OF COMPLETED WELL: 83 ft. ELEVATION:

Depth(s) Groundwater Encountered 1. 25 ft. 2. ft. 3. ft.
 WELL'S STATIC WATER LEVEL 25 ft. below land surface measured on mo/day/yr 5-3-89
 Pump test data: Well water was ft. after hours pumping gpm
 Est. Yield 800 gpm: Well water was 54 ft. after 2 hours pumping 750 gpm
 Bore Hole Diameter 30 in. to 83 ft., and in. to ft.
 WELL WATER TO BE USED AS:
 5 Public water supply 8 Air conditioning 11 Injection well
 1 Domestic 3 Feedlot 6 Oil field water supply 9 Dewatering 12 Other (Specify below)
 2 Irrigation 4 Industrial 7 Lawn and garden only 10 Monitoring well
 Was a chemical/bacteriological sample submitted to Department? Yes No X; If yes, mo/day/yr sample was submitted
 Water Well Disinfected? Yes X No

5 TYPE OF BLANK CASING USED: 5 Wrought iron 8 Concrete tile CASING JOINTS: Glued Clamped

1 Steel 3 RMP (SR) 6 Asbestos-Cement 9 Other (specify below) Welded
 2 PVC 4 ABS 7 Fiberglass Threaded
 Blank casing diameter 16 in. to 41 ft., Dia 51 ft. to 61 ft., Dia in. to ft.
 Casing height above land surface 12 in., weight 25.6 lbs./ft. Wall thickness or gauge No. 616

TYPE OF SCREEN OR PERFORATION MATERIAL: 7 PVC 10 Asbestos-cement
 1 Steel 3 Stainless steel 5 Fiberglass 8 RMP (SR) 11 Other (specify)
 2 Brass 4 Galvanized steel 6 Concrete tile 9 ABS 12 None used (open hole)

SCREEN OR PERFORATION OPENINGS ARE: 5 Gauzed wrapped 8 Saw cut 11 None (open hole)
 1 Continuous slot 3 Mill slot 6 Wire wrapped 9 Drilled holes
 2 Louvered shutter 4 Key punched 7 Torch cut 10 Other (specify) 051 Slot

SCREEN-PERFORATED INTERVALS: From 41 ft. to 51 ft., From ft. to ft.
 From 61 ft. to 83 ft., From ft. to ft.
 GRAVEL PACK INTERVALS: From 20 ft. to 83 ft., From ft. to ft.
 From ft. to ft., From ft. to ft.

6 GROUT MATERIAL: 1 Neat cement 2 Cement grout 3 Bentonite 4 Other

Grout Intervals: From 0 ft. to 20 ft., From ft. to ft., From ft. to ft.
 What is the nearest source of possible contamination:
 1 Septic tank 4 Lateral lines 7 Pit privy 10 Livestock pens 14 Abandoned water well
 2 Sewer lines 5 Cess pool 8 Sewage lagoon 11 Fuel storage 15 Oil well/Gas well
 3 Watertight sewer lines 6 Seepage pit 9 Feedyard 12 Fertilizer storage 16 Other (specify below)
 13 Insecticide storage

Direction from well? None within 1/2 mile How many feet?

FROM	TO	LITHOLOGIC LOG	FROM	TO	PLUGGING INTERVALS
0	2	Sandy Top Soil			
2	9	Sandy Brown Clay			
9	13	Fine Sand			
13	37	Medium Coarse Sand and Gravel			
37	40	Green Sandy Clay			
40	51	Medium Sand			
51	61	Green Sandy Clay			
61	81	Medium Coarse Sand and Gravel			
81	83	Red Shale			

7 CONTRACTOR'S OR LANDOWNER'S CERTIFICATION: This water well was (1) constructed, (2) reconstructed, or (3) plugged under my jurisdiction and was completed on (mo/day/year) 5-3-89 and this record is true to the best of my knowledge and belief. Kansas Water Well Contractor's License No. 138 This Water Well Record was completed on (mo/day/yr) 5-10-89 under the business name of Peterson Irrigation, Inc. by (signature) Mike Peterson