


USE TYPEWRITER OR BALL POINT PEN-PRESS FIRMLY, PRINT CLEARLY.

WATER WELL RECORD
KSA 82a-1201-1215

Kansas Department of Health and Environment-Division of Environment (Water well Contractors) Topeka, Kansas 66620

1. Location of well: County KINGMAN Fraction NW 1/4 SW 1/4 NW 1/4 Section number 25 Township number T 27 S R 8 E(N) Range number

2. Distance and direction from nearest town or city: 1 1/2 mi W - 1 3/4 N Street address of well location if in city: KINGMAN
3. Owner of well: BERNARD THISEN R.R. or street: RFD 1 City, state, zip code: KINGMAN, KS 67028

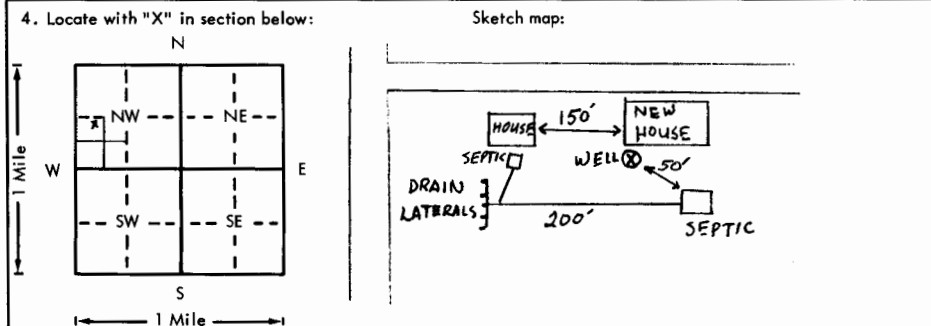

6. Bore hole dia. 10 in. Completion date 7/13/79
Well depth 39 ft.
7. Cable tool Rotary Driven Dug Hollow rod Jetted Bored Reverse rotary
8. Use: Domestic Public supply Industry Irrigation Air conditioning Stock Lawn Oil field water Other
9. Casing: Material PLASTIC Height: (Above) or below
Threaded Welded GLUE Surface 12 in. RMP PVC Weight 2327 lbs./ft. Dia. 5 in. to 29 ft. depth Wall Thickness: inches or Dia. 5 in. to 29 ft. depth gage No. 258

5. Type and color of material	From	To
<u>TOP SOIL</u>	<u>0</u>	<u>1</u>
<u>BROWN CLAY</u>	<u>1</u>	<u>4</u>
<u>SANDY CLAY</u>	<u>4</u>	<u>7</u>
<u>FINE SAND</u>	<u>7</u>	<u>10</u>
<u>VERY FINE/FINE/MED SAND</u>	<u>10</u>	<u>37</u>
<u>GRAVEL MIXED w/CLAY</u>	<u>37</u>	<u>39</u>
<u>CLAY</u>	<u>39</u>	<u>42</u>
<u>RED BED</u>	<u>42</u>	

10. Screen: Manufacturer's name PUMPCO
Type PVC Dia. 5"
Slot/gauge .030 Length 10'
Set between 29 ft. and 39 ft.
Gravel pack? Size range of material 1/8-3/8
11. Static water level: 23 ft. below land surface Date 7/18/79 mo./day/yr.
12. Pumping level below land surfaces:
40 ft. after 1 1/2 hrs. pumping 40 g.p.m.
60 ft. after hrs. pumping g.p.m.
Estimated maximum yield 60 g.p.m.
13. Water sample submitted: mo./day/yr.
 Yes No Date
14. Well head completion:
 Pitless adapter 12 inches above grade
15. Well grouted?
With: Neat cement Bentonite Concrete
Depth: From 4 ft. to 10 ft.
16. Nearest source of possible contamination:
ft. 50 Direction SE Type SEPTIC
Well disinfected upon completion? Yes No
17. Pump: Not installed
Manufacturer's name STA-RITE
Model number 30PYE025 HP 1 Volts 230
Length of drop pipe 30 ft. capacity 40 g.p.m.
Type:
 Submersible Turbine
 Jet Reciprocating
 Centrifugal Other

18. Elevation: _____
19. Remarks: _____
Topography:
 Hill
 Slope
 Upland
 Valley

20. Water well contractor's certification:
This well was drilled under my jurisdiction and this report is true to the best of my knowledge and belief.
SOUTH CENTRAL INC. 355
Business name License No.
Address 635 So. MAIN, KINGMAN, KS
Signed Dean & Wallace Date 7/11/79
Authorized representative

27
R
S
Sec
1/4
1/4
1/4
NW
SW
NW