

USE TYPEWRITER OR BALL POINT PEN-PRESS FIRMLY, PRINT CLEARLY.


T R EW sec 1/4 1/4 1/4 No.

WATER WELL RECORD
KSA 82a-1201-1215

Kansas State Dept. Of Health
(Water Well Contractors)
Forbes-Bldg. 740
Topeka, Kansas 66620

1 Location of well: County Lawrence Township name HOOSIER Fraction SE 1/4 NE 1/4 Section number 25 Town number T27S Range number R8W

Distance and direction from nearest town or city: 1 MILE WEST 1/2 NORTH
Street address of well location if in city: KINDSMAN KANSAS
3 Owner of well: EVERETT CONVERSE
Address: KINDSMAN KANSAS

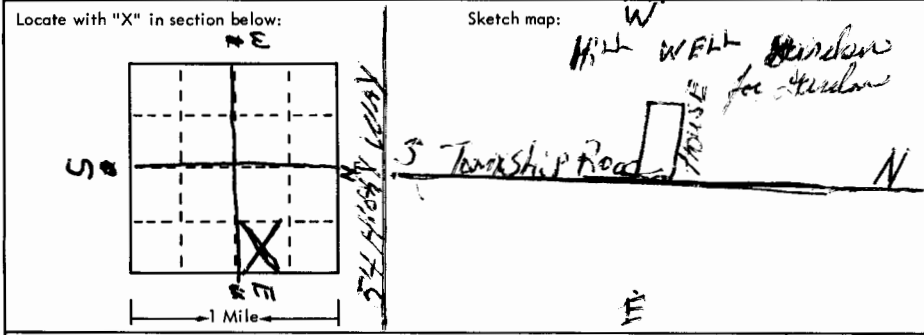

4 Well depth: 55 ft. Date of completion 3-6-75
Well diameter: 8 in. ITS BONE HOLE
5 Cable tool Rotary Driven Dug
 Hollow rod Jetted Bored Reverse rotary
6 Use: Domestic Public supply Industry
 Irrigation Air conditioning Commercial
 Test well For WATER
7 Casing: Material PVC Height: above/below
Threaded Welded Surface 24 in.
Digm. 5 in. to 55 ft. depth Drive shoe? Yes No

2	Type and color of material	From	To
	<u>SOIL</u>	<u>0</u>	<u>1</u>
	<u>Sand and clay</u>	<u>1</u>	<u>30</u>
	<u>Clay</u>	<u>30</u>	<u>40</u>
	<u>Sand Fine</u>	<u>45</u>	<u>50</u>
	<u>Gravel Course</u>	<u>55</u>	
	<u>Water Well TOTAL Depth</u> <u>55 feet to Clay</u> <u>Bottom</u>		

(use a second sheet if needed)

8 Screen: Manufacturer Jess & Lowell
Type 4's Dia. 5
Slot/gauze 1/16 Length 10 feet
Set between 45 ft. and 55 ft.
Fittings: Gravel pack Yes No Size range of material _____
9 Static water level: 30 ft. below land surface Date 3-6-75
10 Pumping level below land surfaces:
____ ft. after ____ hrs. pumping ____ g.p.m.
____ ft. after N/A hrs. pumping ____ g.p.m.
Estimated maximum yield ____ g.p.m.
11 Water sample submitted:
 Yes No Date 3-6-75
12 Well head completion: NOT INSTALLED
 Pitless adapter Inches above grade
13 Well grouted? Yes No
 Neat cement Bentonite
Depth: From 1 ft. to 10 ft.
14 Nearest source of possible contamination:
ft. _____ Direction _____ Type _____
Well disinfected upon completion? Yes No
15 Pump: Not installed
Manufacturer's name _____
Model number _____ HP _____ Volts _____
Length of drop pipe _____ ft. capacity _____ g.p.m.
Type:
 Submersible Turbine
 Jet Reciprocating
 Centrifugal Other

16 Remarks: elevation

Topography:
 Hill
 Slope
 Upland
 Valley

17 Water well contractor's certification:
This well was drilled under my jurisdiction and this report is true to the best of my knowledge and belief.
WEBERWEL Service 226
Business name _____ License No. _____
Address Michelle Koman
Signed Tom Weber Date 3-6-75
Authorized representative