


USE TYPEWRITER OR BALL POINT PEN-PRESS FIRMLY, PRINT CLEARLY.

WATER WELL RECORD
KSA 82a-1201-1215

Kansas Department of Health and Environment-Division of Environment
(Water well Contractors)
Topeka, Kansas 66620

1. Location of well: County **Kingman** Fraction **NW 1/4 NW 1/4 NE 1/4** Section number **26** Township number **T 27 S R 8 E** W

2. Distance and direction from nearest town or city: **Approx. 2 mi. NW of Kingman**
Street address of well location if in city:
3. Owner of well: **Dick Funke**
R.R. or street: **Route 3**
City, state, zip code: **Kingman, KS 67068**

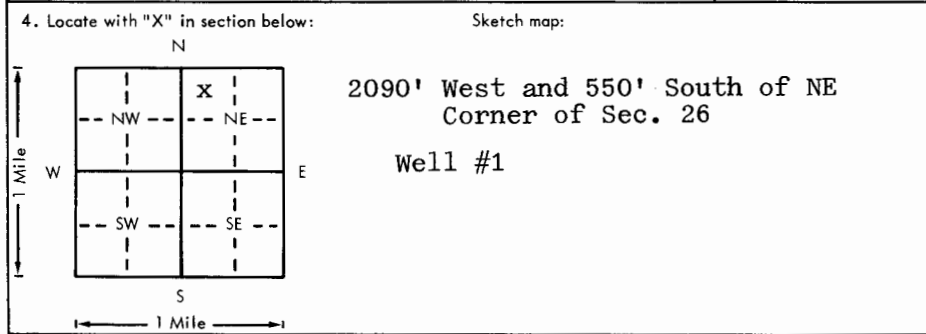

6. Bore hole dia. 24 in. Completion date 6-20-79
Well depth 64 ft. Pump Set 7-26-79

7. Cable tool Rotary Driven Dug
 Hollow rod Jetted Bored Reverse rotary

8. Use: Domestic Public supply Industry
 Irrigation Air conditioning Stock
 Lawn Oil field water Other

9. Casing: Material steel Height: Above or below
Threaded Welded Surface 12 in.
RMP PVC Weight 30.3 lbs./ft.
Dia. 16 in. to 30 ft. depth Wall Thickness: inches or
Dia. 16 in. to 52 ft. depth gage No. 7 ga.

5. Type and color of material	From	To
Sandy top soil	0	22
Brown clay	22	23
Fine sand	23	25
Brown clay	25	28
Sand & gravel	28	36
<input checked="" type="checkbox"/> White clay	36	44
Fine sand	44	47
Gray hard clay	47	51
Fine sand & gravel	51	62
(Use a second sheet if needed)		

10. Screen: Manufacturer's name Doerr
Type Double-slot Dia. 16"
Slot gauze 1/8" Length 24'
Set between 30 ft. and 42 ft.
52 ft. and 64 ft.
Gravel pack? Yes Size range of material 3/8-200

11. Static water level: 17'3" ft. below land surface Date 6-20-79 mo./day/yr.

12. Pumping level below land surfaces:
57'4" ft. after 1/2 hrs. pumping 300 g.p.m.
_____ ft. after _____ hrs. pumping _____ g.p.m.
Estimated maximum yield 320 g.p.m.

13. Water sample submitted: _____ mo./day/yr.
 Yes No Date _____

14. Well head completion:
 Pitless adapter 12 Inches above grade

15. Well grouted? Yes
With: Neat cement Bentonite Concrete
Depth: From 0 ft. to 10 ft.

16. Nearest source of possible contamination: FIELD
ft. _____ Direction _____ Type _____
Well disinfected upon completion? Yes No

17. Pump: _____ Not installed
Manufacturer's name Berkeley Pump Co.
Model number 6S2BH-5P 15 Volts 460
Length of drop pipe 55 ft. capacity 250 g.p.m.
Type:
 Submersible NO Turbine
 Jet Reciprocating
 Centrifugal Other

18. Elevation: _____
Topography:
 Hill
 Slope
 Upland
 Valley

19. Remarks: _____

20. Water well contractor's certification:
This well was drilled under my jurisdiction and this report is true to the best of my knowledge and belief.
Clarke Well & Eq., Inc. 185
Business name Great Bend, KS 67530 License No. _____
Address _____
Signed [Signature] 7-27-79 Date
Authorized representative

27-80-216
Sec 1/4 1/4 1/4 1/4