


USE TYPEWRITER OR BALL POINT PEN-PRESS FIRMLY, PRINT CLEARLY.

WATER WELL RECORD
KSA 82a-1201-1215

Kansas Department of Health and Environment-Division of Environment (Water well Contractors) Topeka, Kansas 66620

1. Location of well: County KINGMAN Fraction SW 1/4 NE 1/4 1/4 Section number 29 Township number T 27 S Range number R 8 W E/W

2. Distance and direction from nearest town or city: 5W 2N OF KINGMAN, KS Street address of well location if in city: KINGMAN, KS
3. Owner of well: PAT MALONEY R.R. or street: City, state, zip code: KINGMAN, KS

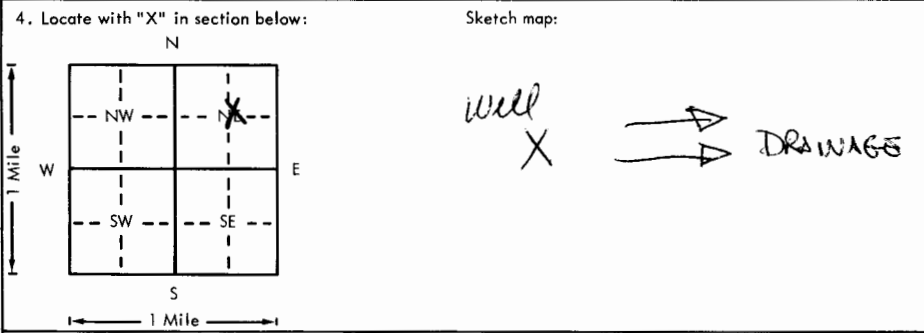

6. Bore hole dia. 3.6 in. Completion date 20 June 79
Well depth 63 ft.
7. Cable tool Rotary Driven Dug
 Hollow rod Jetted Bored Reverse rotary
8. Use: Domestic Public supply Industry
 Irrigation Air conditioning Stock
 Lawn Oil field water Other
9. Casing: Material STL Height Above or below
Threaded Welded Surface 12 in.
RMP PVC Weight _____ lbs./ft.
Dia. 1.6 in. to 41 ft. depth Wall Thickness: inches or
Dia. _____ in. to _____ ft. depth gage No. 188

5. Type and color of material	From	To
<u>SOIL, SANDY</u>	<u>0</u>	<u>2</u>
<u>SILT, BROWN</u>	<u>2</u>	<u>5</u>
<u>SAND, FINE TO COARSE</u>	<u>5</u>	<u>37</u>
<u>CLAY, GRAY</u>	<u>37</u>	<u>40</u>
<u>SAND, FINE TO COARSE</u>	<u>40</u>	<u>44</u>
<u>CLAY, GRAY</u>	<u>44</u>	<u>47</u>
<u>SAND, MED TO COARSE & COARSE GRAVEL</u>	<u>47</u>	<u>63</u>
<u>SHALE, RED</u>	<u>63</u>	<u>64</u>

10. Screen: Manufacturer's name DOER & JOHNSON
Type _____ Dia. 16"
Slot/gauze 1/8 Length 22'
Set between 41 ft. and 53 DOER ft.
53 ft. and 63 JOHNSON ft.
Gravel pack? Size range of material 1/4 X 3/8
11. Static water level: _____ mo./day/yr.
23.5 ft. below land surface Date 20 June 79
12. Pumping level below land surfaces:
39.5 ft. after 1 hrs. pumping 700 g.p.m.
46.5 ft. after 1 hrs. pumping 800 g.p.m.
Estimated maximum yield 1000 g.p.m.
13. Water sample submitted: _____ mo./day/yr.
 Yes No Date _____
14. Well head completion: _____
 Pitless adapter 12 Inches above grade
15. Well grouted?
With: Neat cement Bentonite Concrete
Depth: From 0 ft. to 10 ft.
16. Nearest source of possible contamination: NONE
ft. _____ Direction _____ Type _____
Well disinfected upon completion? Yes No
17. Pump: _____ Not installed
Manufacturer's name Simmons
Model number _____ HP 40 Volts 480
Length of drop pipe 50 ft. capacity 700 g.p.m.
Type: _____
 Submersible Turbine
 Jet Reciprocating
 Centrifugal Other

18. Elevation: Topography: Hill Slope Upland Valley

19. Remarks: 4' X 4' X 10" Concrete slab poured at surface

20. Water well contractor's certification: This well was drilled under my jurisdiction and this report is true to the best of my knowledge and belief.
Central Well & Pump 325
Business name License No. _____
Address Box 1032 Pratt, KS
Signed Patton Muehl Date 22 June 79
Authorized representative

27 - 29 SW NE NE