

C.S. OSNER H3


1 LOCATION OF WATER WELL:	Fraction	Section Number	Township Number	Range Number
County: KINGMAN	C 5 1/2 1/4 NE 1/4	35	T 27 S	R 8 EOW

Distance and direction from nearest town or city street address of well if located within city?

KINGMAN 1 1/2 W 1/2 N WESTSIDE

2 WATER WELL OWNER: H30 DRILLING INC.	C.S. OSNER KINGMAN, KS
RR#, St. Address, Box # 251 N. WATER	Board of Agriculture, Division of Water Resources
City, State, ZIP Code WICHITA, KS 67202	Application Number: T82-59

3 LOCATE WELL'S LOCATION WITH AN "X" IN SECTION BOX:

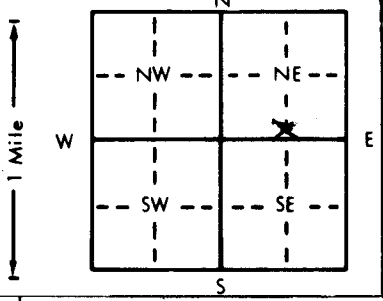

4 DEPTH OF COMPLETED WELL: 47 ft.	ELEVATION:
Depth(s) Groundwater Encountered 1. 18 ft. 2. . ft. 3. . ft.	
WELL'S STATIC WATER LEVEL 15 ft. below land surface measured on mo/day/yr 1-21-82	
Pump test data: Well water was . ft. after . hours pumping . gpm	
Est. Yield . gpm; Well water was . ft. after . hours pumping . gpm	
Bore Hole Diameter 7 7/8 in. to 4.7 ft., and . in. to . ft.	
WELL WATER TO BE USED AS:	
1 Domestic 3 Feedlot 6 Oil field water supply 9 Dewatering 12 Other (Specify below)	
2 Irrigation 4 Industrial 7 Lawn and garden only 10 Observation well	
5 Public water supply 8 Air conditioning 11 Injection well	
Was a chemical/bacteriological sample submitted to Department? Yes . No .; If yes, mo/day/yr sample was submitted	
Water Well Disinfected? Yes No	

5 TYPE OF BLANK CASING USED:	5 Wrought iron	8 Concrete tile	CASING JOINTS: Glued X Y Clamped
1 Steel 3 RMP (SR)	6 Asbestos-Cement	9 Other (specify below)	Welded
2 PVC 4 ABS	7 Fiberglass		Threaded
Blank casing diameter 5 in. to 2.7 ft., Dia . in. to . ft., Dia . in. to . ft.			
Casing height above land surface 12 in., weight 267 lbs./ft. Wall thickness or gauge No. 214			
TYPE OF SCREEN OR PERFORATION MATERIAL:	7 PVC	10 Asbestos-cement	
1 Steel 3 Stainless steel 5 Fiberglass 8 RMP (SR) 11 Other (specify)			
2 Brass 4 Galvanized steel 6 Concrete tile 9 ABS 12 None used (open hole)			
SCREEN OR PERFORATION OPENINGS ARE 1/8	5 Gauzed wrapped	8 Saw cut	11 None (open hole)
1 Continuous slot 3 Mill slot 6 Wire wrapped 9 Drilled holes			
2 Louvered shutter 4 Key punched 7 Torch cut 10 Other (specify)			
SCREEN-PERFORATED INTERVALS: From 2.7 ft. to 4.7 ft., From . ft. to . ft.			
GRAVEL PACK INTERVALS: From 1.7 ft. to 4.7 ft., From . ft. to . ft.			

6 GROUT MATERIAL: 1 Neat cement 2 Cement grout 3 Bentonite 4 Other	
Grout Intervals: From 0 ft. to 10 ft., From . ft. to . ft., From . ft. to . ft.	
What is the nearest source of possible contamination: NONE	
1 Septic tank 4 Lateral lines 7 Pit privy 10 Livestock pens 14 Abandoned water well	
2 Sewer lines 5 Cess pool 8 Sewage lagoon 11 Fuel storage 15 Oil well/Gas well	
3 Watertight sewer lines 6 Seepage pit 9 Feedyard 12 Fertilizer storage 16 Other (specify below)	
13 Insecticide storage	
Direction from well? How many feet?	

FROM	TO	LITHOLOGIC LOG	FROM	TO	LITHOLOGIC LOG
0	15	SANDY SOIL			
15	30	GRAVEL			
30	40	CLAY			
40	47	RED BED.			

7 CONTRACTOR'S OR LANDOWNER'S CERTIFICATION: This water well was (1) constructed, (2) reconstructed, or (3) plugged under my jurisdiction and was completed on (mo/day/year) 1-21-82 and this record is true to the best of my knowledge and belief. Kansas Water Well Contractor's License No. 389 This Water Well Record was completed on (mo/day/yr) under the business name of REISER WATER WELL SERV. INC. by (signature) Rudolph J. Reiser

INSTRUCTIONS: Use typewriter or ball point pen, PLEASE PRESS FIRMLY and PRINT clearly. Please fill in blanks, underline or circle the correct answers. Send top three copies to Kansas Department of Health and Environment, Division of Environment, Environmental Geology Section, Topeka, KS 66620. Send one to WATER WELL OWNER and retain one for your records.

OFFICE USE ONLY
T
R
E
S
1/4
S
1/4
NE 1/4