USE TYPEWRITER OR BALL POINT PEN-PRESS FIRMLY, PRINT CLEARLY.

WATER WELL RECORD
KSA 82a-1201-1215

Kansas Department of Health and Environment-Division of Environment
(Water well Contractors)
Topeka, Kansas 66620

1. Location of well:	County	Fraction	Section number	Township number	Range number
	Kingman	NE 1/4 SE 1/4 SE 1/4	35	T 27 S	R 8 E/(W)

2. Distance and direction from nearest town or city: 2 W, 1/4 N of Kingman
Street address of well location if in city:

3. Owner of well: W. B. Klaver, Jr.
R.R. or street: RR#1
City, state, zip code: Kingman, Ks. 67068

4. Locate with "X" in section below:

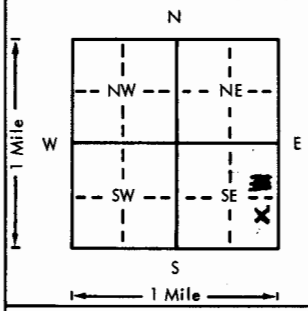

Sketch map:

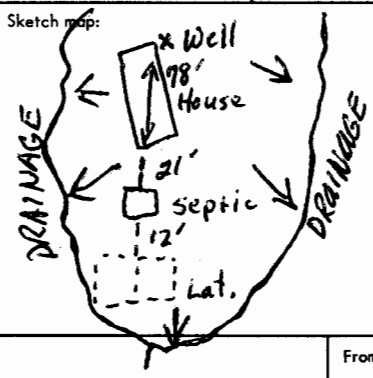

6. Bore hole dia. 7 7/8 in. Completion date Jan 4-77 MKC
Well depth 38 ft.

7. __ Cable tool X Rotary __ Driven __ Dug
__ Hollow rod __ Jetted __ Bored __ Reverse rotary

8. Use: X Domestic __ Public supply __ Industry
__ Irrigation __ Air conditioning __ Stock
__ Lawn __ Oil field water __ Other

9. Casing: Material PLTS Height: (Above) or below
Threaded ___ Welded ___ Surface 14 in.
RMP X PVC ___ Weight 2 lbs./ft.
Dia. 5 in. to 38 ft. depth Wall Thickness: inches or
Dia. ___ in. to ___ ft. depth gage No. 200

10. Screen: Manufacturer's name J & L
Type RMP Dia. 5 in.
Slot/gauze 1/8 Length 10 ft.
Set between 28 ft. and 38 ft.
___ ft. and ___ ft.
Gravel pack? ✓ Size range of material 1/8 - 3/8

11. Static water level: mo./day/yr.
14 ft. below land surface Date 1/4/77

12. Pumping level below land surfaces:
26 ft. after 2 hrs. pumping ___ g.p.m.
___ ft. after ___ hrs. pumping ___ g.p.m.
Estimated maximum yield 8 g.p.m.

13. Water sample submitted: mo./day/yr.
___ Yes ✓ No Date

14. Well head completion:
✓ Pitless adapter 14 Inches above grade

15. Well grouted? X
With: X Neat cement ___ Bentonite ___ Concrete
Depth: From 0 ft. to 16 ft.

16. Nearest source of possible contamination:
ft. 99 Direction S Type Septic Tank
Well disinfected upon completion? X Yes ___ No

17. Pump: ___ Not installed
Manufacturer's name REDA
Model number 20SP6D2 HP 3/4 Volts 220
Length of drop pipe 30 ft. capacity 20 g.p.m.
Type:
✓ Submersible ___ Turbine
___ Jet ___ Reciprocating
___ Centrifugal ___ Other

5. Type and color of material	From	To
Sand	0	6
Clay - Brown	6	18
Sand V-Fine	18	24
Clay	24	28
Med - Course Sand	28	38
Red Bed	38	

(Use a second sheet if needed)

18. Elevation:

Topography:
___ Hill
___ Slope
✓ Upland
___ Valley

19. Remarks:

20. Water well contractor's certification:
This well was drilled under my jurisdiction and this report is true to the best of my knowledge and belief.
Wells Drilling Co. #112
Business name License No.
Address 1130 E. Hwy 54
Signed Dean K Wallace Date 1/18/77
Authorized representative

27 T — 8 R (E) (W) — 35 Sec — NE 1/4 — NE 1/4 — SE 1/4

Forward the white, blue and pink copies to the Department of Health and Environment

Form WWC-5