


1 LOCATION OF WATER WELL: County: Kingman Fraction: NE 1/4 NE 1/4 NE 1/4 Section Number: 36 Township Number: T 27 S Range Number: R 8 E

Distance and direction from nearest town or city street address of well if located within city?
1 W 3/4 Kingman

2 WATER WELL OWNER: Donald Harris
 RR#, St. Address, Box #: Kingman, KS 67068
 City, State, ZIP Code: Kingman, KS 67068
 Board of Agriculture, Division of Water Resources
 Application Number:

3 LOCATE WELL'S LOCATION WITH AN "X" IN SECTION BOX:

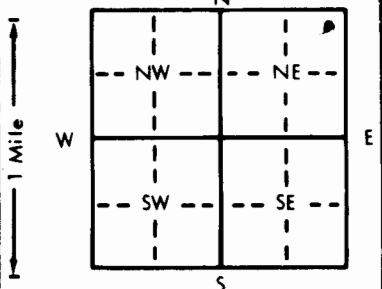

4 DEPTH OF COMPLETED WELL: 43 ft. ELEVATION:
 Depth(s) Groundwater Encountered: 17 ft. 2. 17 ft. 3. 11-14-81 ft.
 WELL'S STATIC WATER LEVEL: 17 ft. below land surface measured on mo/day/yr

Pump test data: Well water was 15 gpm: Well water was 43 ft. after 15 hours pumping 15 gpm
 Est. Yield: 15 gpm: Well water was 43 ft. after 15 hours pumping 15 gpm
 Bore Hole Diameter: 1.0 in. to 4.3 ft., and 4.3 in. to 4.3 ft.
 WELL WATER TO BE USED AS:
 1 Domestic 1 3 Feedlot 1 6 Oil field water supply 1 9 Dewatering 1 12 Other (Specify below)
 2 Irrigation 1 4 Industrial 1 7 Lawn and garden only 1 10 Observation well 1
 Was a chemical/bacteriological sample submitted to Department? Yes No; If yes, mo/day/yr sample was submitted 11-14-81
 Water Well Disinfected? Yes No

5 TYPE OF BLANK CASING USED:
 1 Steel 5 3 RMP (SR) 5 6 Asbestos-Cement 5 9 Other (specify below) 5
 2 PVC 5 4 ABS 5 7 Fiberglass 5 CASING JOINTS: Glued Clamped
 Casing height above land surface: 18 in., weight: 18 lbs./ft. Wall thickness or gauge No. 265

TYPE OF SCREEN OR PERFORATION MATERIAL:
 1 Steel 7 3 Stainless steel 7 5 Fiberglass 7 8 RMP (SR) 7 10 Asbestos-cement 7
 2 Brass 7 4 Galvanized steel 7 6 Concrete tile 7 9 ABS 7 11 Other (specify) 7
 12 None used (open hole) 7
 SCREEN OR PERFORATION OPENINGS ARE:
 1 Continuous slot 7 3 Mill slot 7 5 Gauzed wrapped 7 8 Saw cut 7 11 None (open hole) 7
 2 Louvered shutter 7 4 Key punched 7 6 Wire wrapped 7 9 Drilled holes 7
 7 Torch cut 7 10 Other (specify) 7


6 GROUT MATERIAL: 1 Neat cement 13 Cement grout 3 Bentonite 4 Other 60

What is the nearest source of possible contamination:
 1 Septic tank 1 4 Lateral lines 1 7 Pit privy 1 10 Livestock pens 1 14 Abandoned water well 1
 2 Sewer lines 1 5 Cess pool 1 8 Sewage lagoon 1 11 Fuel storage 1 15 Oil well/Gas well 1
 3 Watertight sewer lines 1 6 Seepage pit 1 9 Feedyard 1 12 Fertilizer storage 1 16 Other (specify below) 1
 13 Insecticide storage 1
 Direction from well? W How many feet? 60

FROM	TO	LITHOLOGIC LOG	FROM	TO	LITHOLOGIC LOG
0	5	Soil			
5	16	Fine Sand			
16	28	clay			
28	43	medi. Sand			

7 CONTRACTOR'S OR LANDOWNER'S CERTIFICATION: This water well was (1) constructed, (2) reconstructed, or (3) plugged under my jurisdiction and was completed on (mo/day/year) 11-14-81 and this record is true to the best of my knowledge and belief. Kansas Water Well Contractor's License No. 140 This Water Well Record was completed on (mo/day/yr) 11-18-81 under the business name of Lymann Bros by (signature) Richard Lymann

INSTRUCTIONS: Use typewriter or ball point pen, PLEASE PRESS FIRMLY and PRINT clearly. Please fill in blanks, underline or circle the correct answers. Send top three copies to Kansas Department of Health and Environment, Division of Environment, Environmental Geology Section, Topeka, KS 66620. Send one to WATER WELL OWNER and retain one for your records.