


1 LOCATION OF WATER WELL: County: **Kingman** Fraction: **SE 1/4 NE 1/4 SE 1/4** Section Number: **13** Township Number: **T 27 S** Range Number: **R 9 NW**

Distance and direction from nearest town or city street address of well if located within city?
1/2 mile north, 3 miles west, 1/4 mile north of BROWN SPUR, Kns.

2 WATER WELL OWNER: **Martha Gardner**
 RR#, St. Address, Box #: **RT#1--Box 69** Board of Agriculture, Division of Water Resources

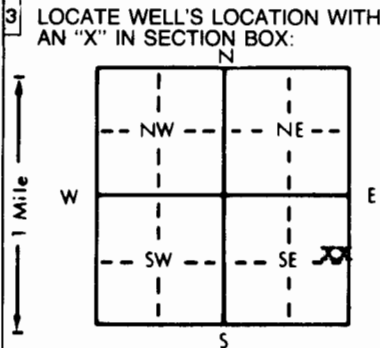

4 DEPTH OF COMPLETED WELL: **APP: 30'** ft. ELEVATION: _____
 Depth(s) Groundwater Encountered 1. ~~12'~~ ft. 2. _____ ft. 3. _____ ft.
 WELL'S STATIC WATER LEVEL: **12'** ft. below land surface measured on mo/day/yr **Sept. 9 - 1996**
 Pump test data: Well water was _____ ft. after _____ hours pumping _____ gpm
 Est. Yield _____ gpm: Well water was _____ ft. after _____ hours pumping _____ gpm
 Bore Hole Diameter: **PLUGGED** to _____ ft., and _____ in. to _____ ft.
 WELL WATER TO BE USED AS:
 1 Domestic 3 Feedlot 6 Oil field water supply 9 Dewatering 12 Other (Specify below)
 2 Irrigation 4 Industrial 7 Lawn and garden only 10 Monitoring well
 Was a chemical/bacteriological sample submitted to Department? Yes _____ No **XX**; If yes, mo/day/yr sample was submitted _____
 Water Well Disinfected? Yes **X** No

5 TYPE OF BLANK CASING USED:
 1 Steel 3 RMP (SR) 5 Wrought iron 8 Concrete tile CASING JOINTS: Glued _____ Clamped _____
 2 PVC 4 ABS 6 Asbestos-Cement 9 Other (specify below) Welded _____
 7 Fiberglass Threaded _____
 Blank casing diameter _____ in. to _____ ft., Dia _____ in. to _____ ft., Dia _____ in. to _____ ft.
 Casing height above land surface _____ in., weight _____ lbs./ft. Wall thickness or gauge No. _____
 TYPE OF SCREEN OR PERFORATION MATERIAL:
 1 Steel 3 Stainless steel 5 Fiberglass **Plugged** 7 PVC 10 Asbestos-cement
 2 Brass 4 Galvanized steel 6 Concrete tile 9 ABS 11 Other (specify) _____
 12 None used (open hole)
 SCREEN OR PERFORATION OPENINGS ARE:
 1 Continuous slot 3 Mill slot 5 Gauzed wrapped 8 Saw cut 11 None (open hole)
 2 Louvered shutter 4 Key punched 6 Wire wrapped 9 Drilled holes
 7 Torch cut 10 Other (specify) _____
 SCREEN-PERFORATED INTERVALS: From _____ ft. to _____ ft., From _____ ft. to _____ ft.
 From _____ ft. to _____ ft., From _____ ft. to _____ ft.
 GRAVEL PACK INTERVALS: From _____ ft. to _____ ft., From _____ ft. to _____ ft.
 From _____ ft. to _____ ft., From _____ ft. to _____ ft.

6 GROUT MATERIAL: 1 Neat cement Cement grout Bentonite 4 Other _____
 Grout Intervals: From **22'** ft. to **16'** ft., From **16'** ft. to **14'** ft., From _____ ft. to _____ ft.
 What is the nearest source of possible contamination:
 1 Septic tank 4 Lateral lines 7 Pit privy 10 Livestock pens 14 Abandoned water well
 Sewer lines 5 Cess pool 8 Sewage lagoon 11 Fuel storage 15 Oil well/Gas well
 3 Watertight sewer lines 6 Seepage pit 9 Feedyard 12 Fertilizer storage 16 Other (specify below)
 13 Insecticide storage

FROM	TO	LITHOLOGIC LOG	FROM	TO	PLUGGING INTERVALS
			23'	16'	Hole Plug .
			16'	14'	Cement.
					WELL in Pit Approximately 6'
					Deep.
					Measurements

7 CONTRACTOR'S OR LANDOWNER'S CERTIFICATION: This water well was (1) constructed, (2) reconstructed, or (3) **plugged** under my jurisdiction and was completed on (mo/day/year) **Sept. 9 1996** and this record is true to the best of my knowledge and belief. Kansas Water Well Contractor's License No. **112** This Water Well Record was completed on (mo/day/yr) **Sept. 13 1996** under the business name of **Wells Drilling Co.** by (signature) *Dal Wells*