USE TYPEWRITER OR BALL POINT PEN-PRESS FIRMLY, PRINT CLEARLY.

WATER WELL RECORD
KSA 82a-1201-1215

Kansas Department of Health and Environment-Division of Environment
(Water well Contractors)
Topeka, Kansas 66620

1. Location of well:	County: Kingman	Fraction: C SW 1/4 (1/4 1/4 1/4)	Section number: 2	Township number: T 27 S	Range number: R 9 W E/W

2. Distance and direction from nearest town or city: 2 1/4 East of Penalosa, Kans.
Street address of well location if in city:

3. Owner of well: Bill Bradshaw
R.R. or street:
City, state, zip code: Penalosa, Ks. 67121

4. Locate with "X" in section below: Sketch map: Center of quarter

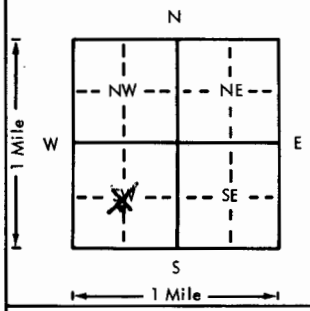

6. Bore hole dia. 28 in. Completion date 15 DEC
Well depth 122 ft.

7. __ Cable tool __ Rotary __ Driven __ Dug
__ Hollow rod __ Jetted __ Bored X Reverse rotary

8. Use: __ Domestic __ Public supply __ Industry
X Irrigation __ Air conditioning __ Stock
__ Lawn __ Oil field water __ Other

9. Casing: Material STL
Threaded ___ Welded X
RMP ___ PVC ___
Dia. 16 in. to 122 ft. depth
Dia. ___ in. to ___ ft. depth
Height: Above or below
Surface 12 in.
Weight ___ lbs./ft.
Wall Thickness: inches or gage No. 7 Ga.

5. Type and color of material	From	To
TOP - Brown Sand	0'	8'
Clay	8'	20'
Medium Brown Sand	20'	31'
Clay	31'	59'
Medium Sand	59'	91'
Clay - yellow	91'	92'
Medium Sand - Course Sand	92'	122'
Red. Bed.		
(Use a second sheet if needed)		

10. Screen: Manufacturer's name W. A. Brown Enterprises
Type Stl. Frac Flow Dia. 16"
Slot/gauze 1/4 Length 60'
Set between 62' ft. and 122 ft.
___ ft. and ___ ft.
Gravel pack? X Size range of material 1/8 - 3/8

11. Static water level: 52 ft. below land surface Date 12/15/76 (mo./day/yr.)

12. Pumping level below land surfaces:
___ ft. after NA hrs. pumping ___ g.p.m.
___ ft. after ___ hrs. pumping ___ g.p.m.
Estimated maximum yield 1200 g.p.m.

13. Water sample submitted: ___ Yes X No Date ___ (mo./day/yr.)

14. Well head completion: ___ Pitless adapter 12 Inches above grade

15. Well grouted? X
With: X Neat cement ___ Bentonite ___ Concrete
Depth: From 3 ft. to 12 ft.

16. Nearest source of possible contamination:
ft. 2500 Direction SE Type Farm Stead
Well disinfected upon completion? X Yes ___ No

17. Pump: ___ Not installed
Manufacturer's name Western Land Roller
Model number 8M HP ___ Volts ___
Length of drop pipe 100 ft. capacity 1400 g.p.m.
Type:
___ Submersible X Turbine
___ Jet ___ Reciprocating
___ Centrifugal ___ Other

T 27 R 9 (W) E Sec 2 1/4 1/4 1/4 1/4 CSE

18. Elevation:
Topography:
___ Hill
X Slope
___ Upland
___ Valley

19. Remarks:

20. Water well contractor's certification:
This well was drilled under my jurisdiction and this report is true to the best of my knowledge and belief.
Wells Drilling Co. 112
Business name License No.
Address 1030 Hiway 54 East
Signed Dal Wells Date Jan 1-79
Authorized representative

Forward the white, blue and pink copies to the Department of Health and Environment

Kingman, Kans.

Form WWC-5