

USE TYPEWRITER OR BALL POINT PEN-PRESS FIRMLY, PRINT CLEARLY.


WATER WELL RECORD  
KSA 82a-1201-1215

Kansas Department of Health and Environment-Division of Environment  
(Water well Contractors)  
Topeka, Kansas 66620

NE-NW-NE

1. Location of well: County Kingman Fraction NW 1/4 NE 1/4 NE 1/4 Section number 3 Township number T 27 S R 9 Range number 9 (W)

2. Distance and direction from nearest town or city: 1 N 1/4 E of Renalosa  
Street address of well location if in city:  
3. Owner of well: Joe Woodson  
R.R. or street: Renalosa, Kans  
City, state, zip code: 67121

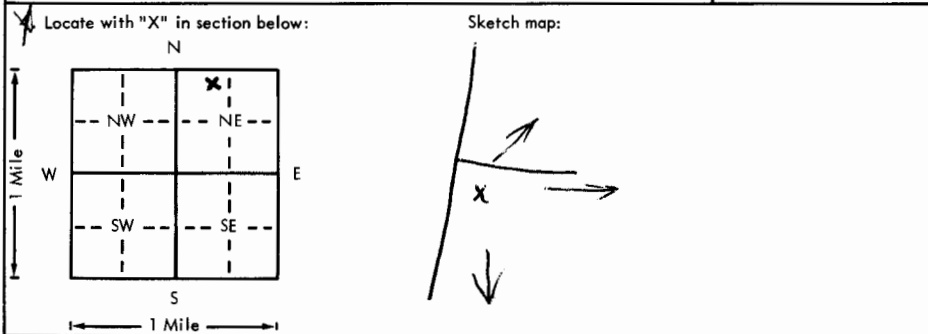

6. Bore hole dia 28 in. Completion date Nov 10 - 78  
Well depth 116 ft.  
7.  Cable tool  Rotary  Driven  Dug  
 Hollow rod  Jetted  Bored  Reverse rotary  
8. Use:  Domestic  Public supply  Industry  
 Irrigation  Air conditioning  Stock  
 Lawn  Oil field water  Other  
9. Casing: Material Steel Height: Above or below  
Threaded  Welded  Surface 16 in.  
RMP  PVC  Weight 7.50 lbs./ft.  
Dia 16 in. to 116 ft. depth  All Thickness: inches or  
Dia.  in. to  ft. depth  gage No. 7.50

5. Type and color of material	From	To
<u>Top Soil</u>	<u>1</u>	<u>6</u>
<u>Fine Sand</u>	<u>6</u>	<u>12</u>
<u>Brown Clay</u>	<u>12</u>	<u>33</u>
<u>Sandy Clay</u>	<u>33</u>	<u>44</u>
<u>Medium Course Sand</u>	<u>44</u>	<u>72</u>
<u>Brown Clay</u>	<u>72</u>	<u>78</u>
<u>Medium Course Sand</u>	<u>78</u>	<u>116</u>
<u>Red Bed</u>		

10. Screen: Manufacturer's name W.A. Brown Enterprises  
Type Free-Flow Dia. 16  
Slot/gauze 1/8 Length 40  
Set between 76 ft. and 116 ft.  
\_\_\_\_\_ ft. and \_\_\_\_\_ ft.  
Gravel pack?  Size range of material 1/8 x 3/8"  
11. Static water level: Nov 10 - 78 mo./day/yr.  
23 ft. below land surface Date \_\_\_\_\_  
12. Pumping level below land surfaces:  
48 ft. after 4 hrs. pumping 980 g.p.m.  
\_\_\_\_\_ ft. after \_\_\_\_\_ hrs. pumping \_\_\_\_\_ g.p.m.  
Estimated maximum yield \_\_\_\_\_ g.p.m.  
13. Water sample submitted: \_\_\_\_\_ mo./day/yr.  
Yes  No  Date \_\_\_\_\_  
14. Well head completion:  
 Pitless adapter \_\_\_\_\_ Inches above grade  
15. Well grouted?   
With:  Neat cement  Bentonite  Concrete  
Depth: From 8 ft. to 19 ft.  
16. Nearest source of possible contamination: Farm Stud  
ft. 1320 Direction SE Type \_\_\_\_\_  
Well disinfected upon completion?  Yes  No  
17. Pump:  Not installed  
Manufacturer's name NA HP \_\_\_\_\_ Volts \_\_\_\_\_  
Model number \_\_\_\_\_  
Length of drop pipe \_\_\_\_\_ ft. capacity \_\_\_\_\_ g.p.m.  
Type:  
 Submersible  Turbine  
 Jet  Reciprocating  
 Centrifugal  Other

18. Elevation:  
Topography:  
 Hill  
 Slope  
 Upland  
 Valley  
19. Remarks:  
(Use a second sheet if needed)

20. Water well contractor's certification:  
This well was drilled under my jurisdiction and this report is true to the best of my knowledge and belief.  
Wells Drilling Co License No. 112  
Business name \_\_\_\_\_  
Address 1030 N. Hwy 54 East  
Signed Kingman, Kans Date \_\_\_\_\_  
Authorized representative

T 27 S R 9 (W) Sec 3

NE NW NE 1/4 NE NW NE 1/4