USE TYPEWRITER OR BALL POINT PEN-PRESS FIRMLY, PRINT CLEARLY.

WATER WELL RECORD
KSA 82a-1201-1215

Kansas Department of Health and Environment-Division of Environment
(Water well Contractors)
Topeka, Kansas 66620

1. Location of well:	County	Fraction	Section number	Township number	Range number
	Kingman	1/4 c 1/4 ~~x~~ nw 1/4	5	T 27 S	R 9 E (W)

2. Distance and direction from nearest town or city:
1-W 3/4-N east side from Penalosa, Ks.
Street address of well location if in city:

3. Owner of well: Pickrell Drilling Co.
R.R. or street: 110 N. Market
City, state, zip code: Wichita, Ks. 67202

4. Locate with "X" in section below: Sketch map:

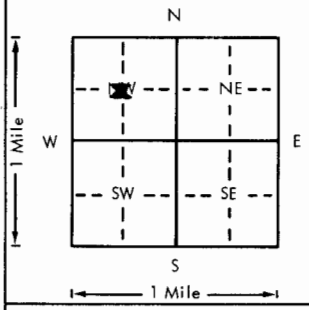

6. Bore hole dia. 8 in. Completion date
Well depth 120 ft. 4-6-76

7. __ Cable tool X Rotary __ Driven __ Dug
__ Hollow rod __ Jetted __ Bored __ Reverse rotary

8. Use: __ Domestic __ Public supply __ Industry
__ Irrigation __ Air conditioning __ Stock
__ Lawn X Oil field water __ Other

9. Casing: Material pvc Height: Above or ~~Below~~
Threaded ___ Welded ___ Surface 18 in.
RMP ___ PVC X Weight ___ lbs./ft.
Dia. 4 in. to 120 ft. depth Wall Thickness: inches or
Dia. ___ in. to ___ ft. depth gage No. .237

5. Type and color of material	From	To
sandy top soil	0	½
clay	½	3
fine sand	3	8
good clean sand & gravel	8	30
clay	30	48
sand	48	53
clay	53	65
sand & clay	65	95
clay	95	100
good clean sand & gravel	100	120
(Use a second sheet if needed)		

10. Screen: Manufacturer's name CertainTeed
Type pvc Dia.
Slot/~~gage~~ 1/16 Length 20
Set between 100 ft. and 120 ft.
___ ft. and ___ ft.
Gravel pack? X Size range of material ¾ 3/8

11. Static water level: mo./day/yr.
49 ft. below land surface Date 4-6-76

12. Pumping level below land surfaces:
60 ft. after 1 hrs. pumping 80 g.p.m.
___ ft. after ___ hrs. pumping ___ g.p.m.
Estimated maximum yield 300 g.p.m.

13. Water sample submitted: mo./day/yr.
__ Yes X No Date

14. Well head completion:
__ Pitless adapter ___ Inches above grade

15. Well grouted? X
With: X Neat cement __ Bentonite __ Concrete
Depth: From 0 ft. to 10 ft.

16. Nearest source of possible contamination:
ft. 200 Direction nw Type gaswell
Well disinfected upon completion? X Yes __ No

17. Pump: X Not installed
Manufacturer's name
Model number HP Volts
Length of drop pipe ft. capacity g.p.m.
Type:
__ Submersible __ Turbine
__ Jet __ Reciprocating
__ Centrifugal __ Other

18. Elevation:

Topography:
__ Hill
__ Slope
X Upland
__ Valley

19. Remarks:

20. Water well contractor's certification:
This well was drilled under my jurisdiction and this report is true to the best of my knowledge and belief.
Rosencrantz-Bemis 134
Business name License No.
Address Great Bend, Kansas 67530
Signed S. Kilgore Date 6-19-79
Authorized Representative

T 27 R 9 E (W) Sec 5 1/4 1/4 1/4 C NW

Forward the white, blue and pink copies to the Department of Health and Environment

Form WWC-5