USE TYPEWRITER OR BALL POINT PEN-PRESS FIRMLY, PRINT CLEARLY.

WATER WELL RECORD
KSA 82a-1201-1215

Kansas Department of Health and Environment-Division of Environment
(Water well Contractors)
Topeka, Kansas 66620

1. Location of well:	County	Fraction	Section number	Township number	Range number
	Kingman	1/4 1/4 cnw 1/4 NW	6	T 27 S	R 9w E/W

2. Distance and direction from nearest town or city: 2w 3/4n 1/4e
Street address of well location if in city: Penalosa, Ks.

3. Owner of well: Vleda Bradshaw
R.R. or street: Penalosa Ks.
City, state, zip code: 67121

4. Locate with "X" in section below:

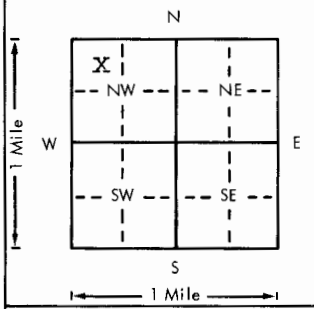

Sketch map:

6. Bore hole dia. 30 in. Completion date _____
Well depth 164 ft. 4-7-78

7. __ Cable tool __ Rotary __ Driven __ Dug
__ Hollow rod __ Jetted __ Bored X Reverse rotary

8. Use: __ Domestic __ Public supply __ Industry
X Irrigation __ Air conditioning __ Stock
__ Lawn __ Oil field water __ Other

9. Casing: Material iron Height: Above ~~XXXX~~
Threaded ____ Welded X Surface 12 in.
RMP ____ PVC ____ Weight 30 lbs./ft.
Dia. 16 in. to 164 ft. depth Wall Thickness inches or
Dia. ____ in. to ____ ft. depth gage No. 3/16"

5. Type and color of material	From	To
Top Soil-Clay	0	40
Sand	40	60
Clay	60	80
Sand	80	100
Sand-Gravel	100	164

(Use a second sheet if needed)

10. Screen: Manufacturer's name Doerr
Type iron Dia. 16"
Slot/gauze 1/8" Length 60'
Set between 104 ft. and 164 ft.
____ ft. and ____ ft.
Gravel pack? X Size range of material 1/4-3/4"

11. Static water level: mo./day/yr.
45 ft. below land surface Date 4-7-78

12. Pumping level below land surfaces:
____ ft. after ____ hrs. pumping ____ g.p.m.
____ ft. after ____ hrs. pumping ____ g.p.m.
Estimated maximum yield 1500 g.p.m.

13. Water sample submitted: mo./day/yr.
__ Yes X No Date ____

14. Well head completion:
__ Pitless adapter 18 Inches above grade

15. Well grouted? X
With: X Neat cement ____ Bentonite ____ Concrete
Depth: From 0 ft. to 10 ft.

16. Nearest source of possible contamination None
ft. ____ Direction ____ Type ____
Well disinfected upon completion? ____ Yes X No

17. Pump: X Not installed
Manufacturer's name ____
Model number ____ HP ____ Volts ____
Length of drop pipe ____ ft. capacity ____ g.p.m.
Type:
__ Submersible __ Turbine
__ Jet __ Reciprocating
__ Centrifugal __ Other

18. Elevation:

Topography:
__ Hill
__ Slope
X Upland
__ Valley

19. Remarks:

20. Water well contractor's certification:
This well was drilled under my jurisdiction and this report is true to the best of my knowledge and belief.
Kellys Waterwell Ser 186
Business name License No.
Address R2 Great Bend, Ks.
Signed Kelly Price Date 9-22-79
Authorized representative

27 T — 9 R (W) E — 6 Sec — cnw 1/4 1/4 1/4

Forward the white, blue and pink copies to the Department of Health and Environment

Form WWC-5