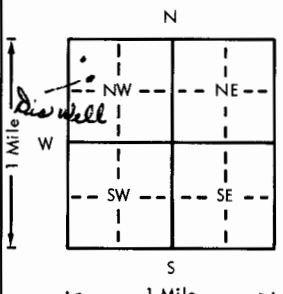
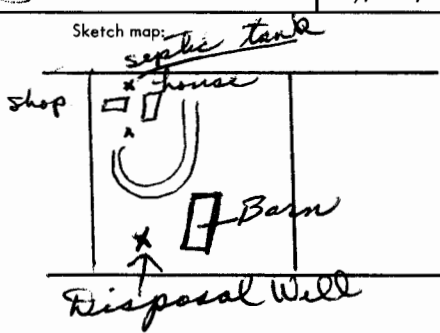


USE TYPEWRITER OR BALL POINT PEN-PRESS FIRMLY, PRINT CLEARLY.

WATER WELL RECORD
KSA 82a-1201-1215

Kansas Department of Health and Environment-Division of Environment
(Water well Contractors)
Topeka, Kansas 66620

1. Location of well: County <u>Kingman</u> Fraction <u>NW 1/4 NW 1/4 NW 1/4</u> Section number <u>8</u> Township number <u>T 27 S R 9</u> Range number <u>EW</u>	
2. Distance and direction from nearest town or city: <u>1 mi west of Penalosa.</u> 3. Owner of well: <u>Loren Bradshaw</u> R.R. or street: _____ City, state, zip code: <u>Penalosa, Kans 67121</u>	
4. Locate with "X" in section below:  Sketch map: 	
6. Bore hole dia. <u>2 1/4</u> in. Completion date <u>Sept 27-78</u> Well depth <u>132</u> ft.	
7. <input type="checkbox"/> Cable tool <input checked="" type="checkbox"/> Rotary <input type="checkbox"/> Driven <input type="checkbox"/> Dug <input type="checkbox"/> Hollow rod <input type="checkbox"/> Jetted <input type="checkbox"/> Bored <input type="checkbox"/> Reverse rotary	
8. Use: <input type="checkbox"/> Domestic <input type="checkbox"/> Public supply <input type="checkbox"/> Industry <input type="checkbox"/> Irrigation <input checked="" type="checkbox"/> Air conditioning <input type="checkbox"/> Stock <input type="checkbox"/> Lawn <input type="checkbox"/> Oil field water <input type="checkbox"/> Other <u>Disposal</u>	
9. Casing: Material <u>PHTS</u> Height: Above or below Threaded <input type="checkbox"/> Welded <input type="checkbox"/> Surface <u>15</u> in. RMP <input checked="" type="checkbox"/> PVC <input type="checkbox"/> Weight _____ lbs./ft. Dia. <u>5</u> in. to <u>132</u> ft. depth Wall Thickness: inches or Dia. _____ in. to _____ ft. depth gage No. <u>200</u>	
10. Screen: Manufacturer's name <u>812</u> Type <u>RMP</u> Dia. <u>5"</u> Slot/gauze <u>1/8"</u> Length <u>20</u> Set between <u>112</u> ft. and <u>132</u> ft. _____ ft. and _____ ft. Gravel pack? <input checked="" type="checkbox"/> Size range of material <u>1/8 x 3/8</u>	
11. Static water level: _____ mo./day/yr. <u>13</u> ft. below land surface Date _____	
12. Pumping level below land surfaces: <u>17</u> ft. after _____ hrs. pumping _____ g.p.m. <u>17</u> ft. after _____ hrs. pumping _____ g.p.m. Estimated maximum yield _____ g.p.m.	
13. Water sample submitted: _____ mo./day/yr. <input type="checkbox"/> Yes <input checked="" type="checkbox"/> No Date _____	
14. Well head completion: <input checked="" type="checkbox"/> Pitless adapter <u>15</u> inches above grade	
15. Well grouted? _____ With: <input type="checkbox"/> Neat cement <input type="checkbox"/> Bentonite <input checked="" type="checkbox"/> Concrete Depth: From <u>13</u> ft. to <u>18</u> ft.	
16. Nearest source of possible contamination: ft. <u>240</u> Direction <u>N</u> Type <u>Septic tank</u> Well disinfected upon completion? <input checked="" type="checkbox"/> Yes <input type="checkbox"/> No	
17. Pump: <input checked="" type="checkbox"/> Not installed Manufacturer's name _____ Model number _____ HP _____ Volts _____ Length of drop pipe _____ ft. capacity _____ g.p.m. Type: <input type="checkbox"/> Submersible <input type="checkbox"/> Turbine <input type="checkbox"/> Jet <input type="checkbox"/> Reciprocating <input type="checkbox"/> Centrifugal <input type="checkbox"/> Other	
(Use a second sheet if needed)	
18. Elevation: Topography: <input type="checkbox"/> Hill <input checked="" type="checkbox"/> Slope <input type="checkbox"/> Upland <input type="checkbox"/> Valley	19. Remarks: <u>Barn has not been used for several years. Ground is farmed on all sides</u>
20. Water well contractor's certification: This well was drilled under my jurisdiction and this report is true to the best of my knowledge and belief. <u>Wells Drilling Co 112</u> Business name _____ License No. _____ Address <u>1950 N. Hwy 54 E - Kingman</u> Signed <u>Del Wells</u> Date <u>Dec 7-78</u> Authorized representative	

27-1-90
 1/4 NW 1/4
 Sec 8
 T 27 S R 9