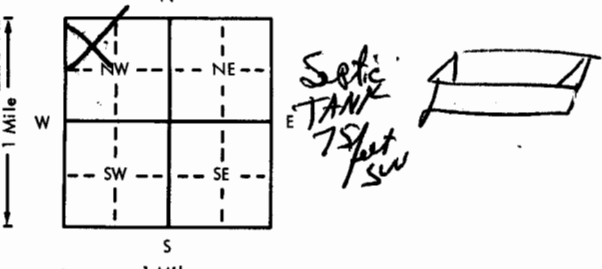


USE TYPEWRITER OR BALL
POINT PEN-PRESS FIRMLY,
PRINT CLEARLY.

WATER WELL RECORD
KSA 82a-1201-1215

Kansas Department of Health and
Environment-Division of Environment
(Water well Contractors)
Topeka, Kansas 66620

1. Location of well: County <u>Linn</u>		Fraction <u>NN 1/4</u> 1/4 1/4 1/4		Section number <u>9</u>	Township number <u>T 27</u> T S R	Range number <u>9</u> R E/W																											
2. Distance and direction from nearest town or city: Street address of well location if in city: <u>SPRUE STREET</u> <u>PENALOSA KANSAS</u>				3. Owner of well: <u>ALICE FOSTER</u> R.R. or street: <u>SPRUE STREET</u> City, state, zip code: <u>67121</u>																													
4. Locate with "X" in section below: Sketch map: 				6. Bore hole dia. <u>8</u> in. Completion date <u>10-29-76</u> Well depth <u>100</u> ft.																													
5. Type and color of material				7. <input checked="" type="checkbox"/> Cable tool <input checked="" type="checkbox"/> Rotary <input type="checkbox"/> Driven <input type="checkbox"/> Dug <input type="checkbox"/> Hollow rod <input type="checkbox"/> Jetted <input type="checkbox"/> Bored <input type="checkbox"/> Reverse rotary																													
				8. Use: <input checked="" type="checkbox"/> Domestic <input type="checkbox"/> Public supply <input type="checkbox"/> Industry <input type="checkbox"/> Irrigation <input type="checkbox"/> Air conditioning <input type="checkbox"/> Stock <input type="checkbox"/> Lawn <input type="checkbox"/> Oil field water <input type="checkbox"/> Other																													
<table border="1" style="width:100%; border-collapse: collapse;"> <thead> <tr> <th></th> <th>From</th> <th>To</th> </tr> </thead> <tbody> <tr><td><u>Top Soil</u></td><td><u>0</u></td><td><u>1</u></td></tr> <tr><td><u>Clay and fine Sand</u></td><td><u>1</u></td><td><u>20</u></td></tr> <tr><td><u>Sand fine</u></td><td><u>20</u></td><td><u>30</u></td></tr> <tr><td><u>Clay blue</u></td><td><u>30</u></td><td><u>40</u></td></tr> <tr><td><u>Sand v fine with brown clay</u></td><td><u>40</u></td><td><u>50</u></td></tr> <tr><td><u>Sand v fine</u></td><td><u>50</u></td><td><u>60</u></td></tr> <tr><td><u>Clay and coarse Sand Brown</u></td><td><u>70</u></td><td><u>80</u></td></tr> <tr><td><u>Sand Coarse Gravel</u></td><td><u>90</u></td><td><u>100</u></td></tr> </tbody> </table> <p><u>100 ft Depth of well</u> <u>Set on Red Shale-</u></p>					From	To	<u>Top Soil</u>	<u>0</u>	<u>1</u>	<u>Clay and fine Sand</u>	<u>1</u>	<u>20</u>	<u>Sand fine</u>	<u>20</u>	<u>30</u>	<u>Clay blue</u>	<u>30</u>	<u>40</u>	<u>Sand v fine with brown clay</u>	<u>40</u>	<u>50</u>	<u>Sand v fine</u>	<u>50</u>	<u>60</u>	<u>Clay and coarse Sand Brown</u>	<u>70</u>	<u>80</u>	<u>Sand Coarse Gravel</u>	<u>90</u>	<u>100</u>	9. Casing: Material <u>plastic</u> Height: Above or below Threaded <input type="checkbox"/> Welded <input type="checkbox"/> Surface <u>2 ft</u> in. RMP <input type="checkbox"/> PVC <input checked="" type="checkbox"/> Weight <u>2</u> lbs./ft. Dia. <u>5</u> in. to <u>100</u> ft. depth Wall Thickness: inches or Dia. <u> </u> in. to <u> </u> ft. depth gage No. <u> </u>		
10. Screen: Manufacturer's name <u>John Holland</u> Type <u>PVC</u> Dia. <u>5</u> Slot/gauze <u>1/16</u> Length <u> </u> Set between <u>90</u> ft. and <u>100</u> ft. <u> </u> ft. and <u> </u> ft. Gravel pack? <input checked="" type="checkbox"/> Size range of material <u>1/4</u>																																	
				11. Static water level: <u>80</u> ft. below land surface Date <u>10-29-76</u> mo./day/yr.																													
				12. Pumping level below land surface: <u> </u> ft. after <u>11</u> hrs. pumping <u> </u> g.p.m. <u> </u> ft. after <u> </u> hrs. pumping <u> </u> g.p.m. Estimated maximum yield <u> </u> g.p.m.																													
				13. Water sample submitted: <u> </u> mo./day/yr. Yes <input checked="" type="checkbox"/> No <input type="checkbox"/> Date <u>10-29-76</u>																													
				14. Well head completion: <u>Well Head</u> <u> </u> Pitless adapter <u>2 ft</u> inches above grade																													
				15. Well grouted? <input checked="" type="checkbox"/> With: <input checked="" type="checkbox"/> Neat cement <input checked="" type="checkbox"/> Bentonite <input type="checkbox"/> Concrete Depth: From <u>1</u> ft. to <u>10</u> ft.																													
				16. Nearest source of possible contamination: ft. <u>75</u> Direction <u>SW</u> Type <u>HUMAN</u> Well disinfected upon completion? <input type="checkbox"/> Yes <input type="checkbox"/> No																													
				17. Pump: <u>Not installed</u> Manufacturer's name <u>LHP Buzby Jet</u> Model number <u>HLV</u> HP <u>1</u> Volts <u>110</u> Length of drop pipe <u>90</u> ft. capacity <u>10</u> g.p.m. Type: <input checked="" type="checkbox"/> Submersible <input type="checkbox"/> Turbine <input checked="" type="checkbox"/> Jet <input type="checkbox"/> Reciprocating <input type="checkbox"/> Centrifugal <input type="checkbox"/> Other																													
				20. Water well contractor's certification: This well was drilled under my jurisdiction and this report is true to the best of my knowledge and belief. <u>Leon G. Wicker</u> <u>Well Serv.</u> Business name <u> </u> License No. <u>226</u> Address <u> </u> Signed <u>Leon G. Wicker</u> Date <u>10-29-76</u> Authorized representative																													
18. Elevation:		19. Remarks: <u>Control SSB to be installed</u> <u>at surface of ground</u> <u>He knows there is a regulation</u>																															
Topography: <input type="checkbox"/> Hill <input checked="" type="checkbox"/> Slope <input checked="" type="checkbox"/> Upland <input type="checkbox"/> Valley																																	