


1 LOCATION OF WATER WELL: County: KINGMAN Fraction NW 1/4 SW 1/4 SE 1/4 Section Number 12 Township Number T 27 S Range Number R 9W ~~10W~~

Distance and direction from nearest town or city street address of well if located within city?
 4 MILES East 3/4 Mile South 1/2 Mile West Of Penalosa, Kns.

2 WATER WELL OWNER: Paul Sallee
 RR#, St. Address, Box #: RT#1 Penalosa, Kns. 67121
 City, State, ZIP Code: Board of Agriculture, Division of Water Resources
 Application Number:

3 LOCATE WELL'S LOCATION WITH AN "X" IN SECTION BOX:

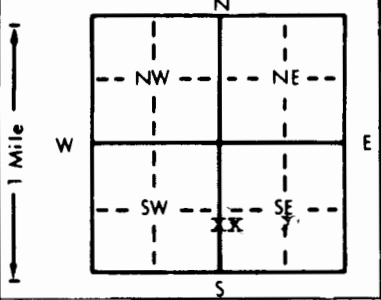

4 DEPTH OF COMPLETED WELL: 116' ft. ELEVATION:

Depth(s) Groundwater Encountered 1. 45' ft. 2. ft. 3. ft.
 WELL'S STATIC WATER LEVEL 42' ft. below land surface measured on mo/day/yr May 3-91
 Pump test data: Well water was NA ft. after hours pumping gpm
 Est. Yield gpm: Well water was ft. after hours pumping gpm
 Bore Hole Diameter 7.7/8 in. to 116' ft., and in. to ft.
 WELL WATER TO BE USED AS:
 X 1 Domestic 3 Feedlot 6 Oil field water supply 9 Dewatering 12 Other (Specify below)
 2 Irrigation 4 Industrial 7 Lawn and garden only 10 Monitoring well
 Was a chemical/bacteriological sample submitted to Department? Yes No X; If yes, mo/day/yr sample was submitted Water Well Disinfected? Yes X No

5 TYPE OF BLANK CASING USED:
 1 Steel 3 RMP (SR) 5 Wrought iron 8 Concrete tile CASING JOINTS: Glued XX Clamped
 XX2 PVC 4 ABS 6 Asbestos-Cement 9 Other (specify below) Welded
 7 Fiberglass Threaded

Blank casing diameter 5" in. to 106' ft., Dia in. to ft., Dia in. to ft.
 Casing height above land surface 14" in., weight 160 lbs./ft. Wall thickness or gauge No. SDR 26

TYPE OF SCREEN OR PERFORATION MATERIAL:
 1 Steel 3 Stainless steel 5 Fiberglass 8 RMP (SR) 10 Asbestos-cement 11 Other (specify)
 2 Brass 4 Galvanized steel 6 Concrete tile 9 ABS 12 None used (open hole)

SCREEN OR PERFORATION OPENINGS ARE:
 1 Continuous slot 3 Mill slot 5 Gauzed wrapped XX 8 Saw cut 11 None (open hole)
 2 Louvered shutter 4 Key punched 6 Wire wrapped 9 Drilled holes
 7 Torch cut 10 Other (specify)

SCREEN-PERFORATED INTERVALS: From 116 ft. to 106 ft., From ft. to ft.
 GRAVEL PACK INTERVALS: From 116 ft. to 26' ft., From ft. to ft.

6 GROUT MATERIAL: 1 Neat cement XX2 Cement grout 3 Bentonite 4 Other
 Grout Intervals: From 26' ft. to 4' ft., From ft. to ft., From ft. to ft.

What is the nearest source of possible contamination:
 X1 Septic tank 4 Lateral lines 7 Pit privy 10 Livestock pens 14 Abandoned water well
 2 Sewer lines 5 Cess pool 8 Sewage lagoon 11 Fuel storage 15 Oil well/Gas well
 3 Watertight sewer lines 6 Seepage pit 9 Feedyard 12 Fertilizer storage 16 Other (specify below)
 13 Insecticide storage
 Direction from well? SW How many feet? App 200'

FROM	TO	LITHOLOGIC LOG	FROM	TO	PLUGGING INTERVALS
0'	13'	Top soil w/ gravel.			
13'	26'	clay.			
26'	32'	Brown sand.			
32'	45'	brown clay.			
45'	61'	fine sand.			
61'	73'	Brown course sand.			
73'	87'	clay.			
87'	101'	course sand.			
101'	106'	White sand.			
106'	116'	course sand & fine gravel.			
		red bed.			

7 CONTRACTOR'S OR LANDOWNER'S CERTIFICATION: This water well was (1) constructed, (2) reconstructed, or (3) plugged under my jurisdiction and was completed on (mo/day/year) May 3 - 91 and this record is true to the best of my knowledge and belief. Kansas Water Well Contractor's License No. 112 This Water Well Record was completed on (mo/day/yr) May 31 - 91 under the business name of Wells Drilling Co. by (signature) Dal Wells