


1 LOCATION OF WATER WELL: County: Kingman Fraction: NE 1/4 NE 1/4 NW 1/4 Section Number: 19 Township Number: T 27S S Range Number: R 9 W

Distance and direction from nearest town or city street address of well if located within city?
1 mi. south 1 mi. west 1/2 mi west of Penalosa, Kans.

2 WATER WELL OWNER: Bob Glascock
 RR#, St. Address, Box #: RT1 Board of Agriculture, Division of Water Resources
 City, State, ZIP Code: Penalosa, Kans. Application Number:

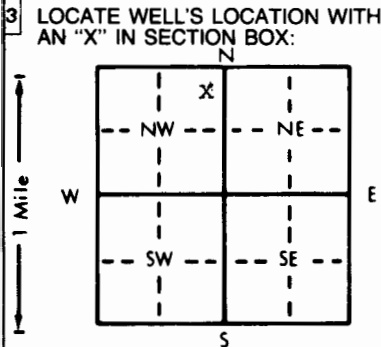

4 DEPTH OF COMPLETED WELL: 143' ft. ELEVATION: ft.
 Depth(s) Groundwater Encountered: 1. 60' ft. 2. ft. 3. ft.
 WELL'S STATIC WATER LEVEL: 57' ft. below land surface measured on mo/day/yr Aug, 13-93
 Pump test data: Well water was NA ft. after hours pumping gpm
 Est. Yield gpm: Well water was ft. after hours pumping gpm
 Bore Hole Diameter: 7 7/8 in. to 143' ft., and in. to ft.
 WELL WATER TO BE USED AS:
 5 Public water supply 8 Air conditioning 11 Injection well
 XX1 Domestic 3 Feedlot 6 Oil field water supply 9 Dewatering 12 Other (Specify below)
 2 Irrigation 4 Industrial 7 Lawn and garden only 10 Monitoring well
 Was a chemical/bacteriological sample submitted to Department? Yes No X; If yes, mo/day/yr sample was submitted
 Water Well Disinfected? Yes XX No

5 TYPE OF BLANK CASING USED:
 1 Steel 3 RMP (SR) 5 Wrought iron 8 Concrete tile CASING JOINTS: Glued X Clamped
 XX2 PVC 4 ABS 6 Asbestos-Cement 9 Other (specify below) Welded
 7 Fiberglass Threaded
 Blank casing diameter: 5" in. to 128' ft., Dia in. to ft., Dia in. to ft.
 Casing height above land surface: 14" in., weight 160 lbs./ft. Wall thickness or gauge No. SDR 26
 TYPE OF SCREEN OR PERFORATION MATERIAL:
 1 Steel 3 Stainless steel 5 Fiberglass 8 RMP (SR) 10 Asbestos-cement
 2 Brass 4 Galvanized steel 6 Concrete tile 9 ABS 11 Other (specify)
 12 None used (open hole)
 SCREEN OR PERFORATION OPENINGS ARE:
 1 Continuous slot 3 Mill slot 5 Gauzed wrapped XX8 Saw cut 11 None (open hole)
 2 Louvered shutter 4 Key punched 6 Wire wrapped 9 Drilled holes
 7 Torch cut 10 Other (specify)
 SCREEN-PERFORATED INTERVALS: From 128' ft. to 143' ft., From ft. to ft.
 From ft. to ft., From ft. to ft.
 GRAVEL PACK INTERVALS: From 143' ft. to 84' ft., From 80' ft. to 22' ft.
 From ft. to ft., From ft. to ft.

6 GROUT MATERIAL: 1 Neat cement 2 Cement grout XX3 Bentonite 4 Other
 Grout Intervals: From 80' ft. to 84' ft., From ft. to 22' ft., From 3' ft. to ft.
 What is the nearest source of possible contamination:
 XXX Septic tank 4 Lateral lines 7 Pit privy 10 Livestock pens 14 Abandoned water well
 2 Sewer lines 5 Cess pool 8 Sewage lagoon 11 Fuel storage 15 Oil well/Gas well
 3 Watertight sewer lines 6 Seepage pit 9 Feedyard 12 Fertilizer storage 16 Other (specify below)
 13 Insecticide storage
 Direction from well? se. How many feet? App. 200'

FROM	TO	LITHOLOGIC LOG	FROM	TO	PLUGGING INTERVALS
0'	5'	Top soil			
5'	23'	Clay.			
23'	39'	fine sand.			
39'	52'	clay / strips of sand.			
52'	59'	sandy clay.			
59'	78'	clay			
78'	85'	clay.			
85'	115'	Medium fine sand.			
115'	126'	Medium fine sand.			
126'	142'	Course sand & Fine gravel.			
142'	143'	Red bed.			

7 CONTRACTOR'S OR LANDOWNER'S CERTIFICATION: This water well was (1) constructed, (2) reconstructed, or (3) plugged under my jurisdiction and was completed on (mo/day/year) Aug 13-93 and this record is true to the best of my knowledge and belief. Kansas Water Well Contractor's License No. 112 This Water Well Record was completed on (mo/day/yr) Sept 4 -93 under the business name of WELLS DRILLING CO. by (signature) Wal Wells