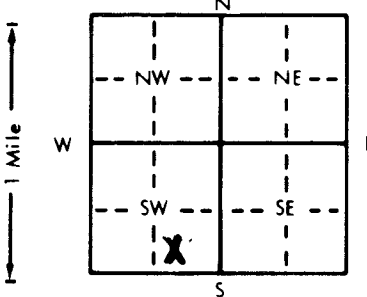


1 LOCATION OF WATER WELL: Fraction SW 1/4 SE 1/4 SW 1/4 Section Number 31 Township Number T 27 S Range Number R 9 E/W  
 County: Kingman

Distance and direction from nearest town or city street address of well if located within city?  
4 3/4 south 1 1/2 west of Penalosa, Ks.

2 WATER WELL OWNER: Leon Fischer Board of Agriculture, Division of Water Resources  
 RR#, St. Address, Box #: Rt. 2  
 City, State, ZIP Code: Cunningham, Ks. Application Number:

3 LOCATE WELL'S LOCATION WITH AN "X" IN SECTION BOX:  4 DEPTH OF COMPLETED WELL: 57 ft. ELEVATION:  
 Depth(s) Groundwater Encountered 1. 17 ft. 2. na ft. 3. na ft.  
 WELL'S STATIC WATER LEVEL 17 ft. below land surface measured on mo/day/yr 7-7-89  
 Pump test data: Well water was na ft. after na hours pumping na gpm  
 Est. Yield na gpm: Well water was na ft. after na hours pumping na gpm  
 Bore Hole Diameter 10 in. to 57 ft., and na in. to na ft.  
 WELL WATER TO BE USED AS: 5 Public water supply 8 Air conditioning 11 Injection well  
 1 Domestic 3 Feedlot 6 Oil field water supply 9 Dewatering 12 Other (Specify below)  
 2 Irrigation 4 Industrial 7 Lawn and garden 10 Monitoring well  
 Was a chemical/bacteriological sample submitted to Department? Yes na No X; If yes, mo/day/yr sample was submitted  
 Water Well Disinfected? Yes hth No

5 TYPE OF BLANK CASING USED: 5 Wrought iron 8 Concrete tile CASING JOINTS: Glued X Clamped  
 1 Steel 3 RMP (SR) 6 Asbestos-Cement 9 Other (specify below) Welded  
 2 PVC 4 ABS 7 Fiberglass Threaded  
 Blank casing diameter 5 in. to 37 ft., Dia. na in. to na ft., Dia. na in. to na ft.  
 Casing height above land surface 18 in., weight 258 lbs./ft. Wall thickness or gauge No.  
 TYPE OF SCREEN OR PERFORATION MATERIAL: 7 PVC 10 Asbestos-cement  
 1 Steel 3 Stainless steel 5 Fiberglass 8 RMP (SR) 11 Other (specify)  
 2 Brass 4 Galvanized steel 6 Concrete tile 9 ABS 12 None used (open hole)  
 SCREEN OR PERFORATION OPENINGS ARE: 5 Gauzed wrapped 8 Saw cut 11 None (open hole)  
 1 Continuous slot 3 Mill slot 6 Wire wrapped 9 Drilled holes  
 2 Louvered shutter 4 Key punched 7 Torch cut 10 Other (specify)  
 SCREEN-PERFORATED INTERVALS: From 37 ft. to 57 ft., From na ft. to na ft.  
 From na ft. to na ft., From na ft. to na ft.  
 GRAVEL PACK INTERVALS: From 20 ft. to 57 ft., From na ft. to na ft.  
 From na ft. to na ft., From na ft. to na ft.

6 GROUT MATERIAL: 1 Neat cement 2 Cement grout 3 Bentonite 4 Other  
 Grout Intervals: From 0 ft. to 20 ft., From na ft. to na ft., From na ft. to na ft.  
 What is the nearest source of possible contamination: 10 Livestock pens 14 Abandoned water well  
1 Septic tank 4 Lateral lines 7 Pit privy 11 Fuel storage 15 Oil well/Gas well  
 2 Sewer lines 5 Cess pool 8 Sewage lagoon 12 Fertilizer storage 16 Other (specify below)  
 3 Watertight sewer lines 6 Seepage pit 9 Feedyard 13 Insecticide storage  
 Direction from well? north west How many feet? 150

FROM	TO	LITHOLOGIC LOG	FROM	TO	PLUGGING INTERVALS
0	2 1/2	Top soil			
2 1/2	5	Sandy red clay			
5	27	Sand and gravel			
27	28	Clay			
28	42	Sand and gravel			
42	47	Clay			
47	56	Sand and gravel			
56	57	Shale			

7 CONTRACTOR'S OR LANDOWNER'S CERTIFICATION: This water well was (1) constructed, (2) reconstructed, or (3) plugged under my jurisdiction and was completed on (mo/day/year) 7-7-89 and this record is true to the best of my knowledge and belief. Kansas Water Well Contractor's License No. 134 This Water Well Record was completed on (mo/day/yr) 7-27-89 under the business name of Rosencrantz-Bemis by (signature) Fredia Hedson

INSTRUCTIONS: Use typewriter or ball point pen. PLEASE PRESS FIRMLY and PRINT clearly. Please fill in blanks, underline or circle the correct answers. Send top three copies to Kansas Department of Health and Environment, Bureau of Water Protection, Topeka, Kansas 66620-7320. Telephone: 913-296-5514. Send one to WATER WELL OWNER and retain one for your records.