


1 LOCATION OF WATER WELL: Fraction NW 1/4 SE 1/4 NE 1/4 Section Number 20 Township Number T 27 S Range Number R 9 ~~E~~W  
 County: Kingman

Distance and direction from nearest town or city street address of well if located within city?  
 2 1/2 Miles South, 1/4 Mile West Of Penalosa, Kans.

2 WATER WELL OWNER: Bill McGovney  
 RR#, St. Address, Box #: RT# 1  
 City, State, ZIP Code: Penalosa, Kans. 67035  
 Board of Agriculture, Division of Water Resources  
 Application Number:

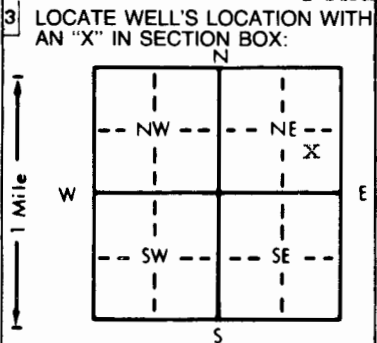

4 DEPTH OF COMPLETED WELL: 95' ft. ELEVATION:  
 Depth(s) Groundwater Encountered 1. 43' ft. 2. ft. 3. ft.  
 WELL'S STATIC WATER LEVEL: 37' ft. below land surface measured on mo/day/yr May 19 1998.  
 Pump test data: Well water was ft. after hours pumping gpm  
 Est. Yield: 25 gpm; Well water was ft. after hours pumping gpm  
 Bore Hole Diameter: 8 1/4" in. to 9.5" ft., and in. to ft.  
 WELL WATER TO BE USED AS:  
 5 Public water supply 8 Air conditioning 11 Injection well  
 1 Domestic 3 Feedlot 6 Oil field water supply 9 Dewatering 12 Other (Specify below)  
 2 Irrigation 4 Industrial 7 Lawn and garden only 10 Monitoring well  
 Was a chemical/bacteriological sample submitted to Department? Yes No ~~XX~~; If yes, mo/day/yr sample was submitted  
 Water Well Disinfected? Yes No ~~XX~~

5 TYPE OF BLANK CASING USED:  
 1 Steel 3 RMP (SR) 5 Wrought iron 8 Concrete tile CASING JOINTS: Glued ~~X~~ Clamped  
 2 PVC ~~XX~~ 4 ABS 6 Asbestos-Cement 9 Other (specify below) Welded  
 7 Fiberglass Threaded  
 Blank casing diameter: 5" in. to 8.5" ft., Dia. in. to ft., Dia. in. to ft.  
 Casing height above land surface: 1.8" in., weight 2.355 lbs./ft. Wall thickness or gauge No. 214  
 TYPE OF SCREEN OR PERFORATION MATERIAL:  
 1 Steel 3 Stainless steel 5 Fiberglass 7 PVC ~~XX~~ 10 Asbestos-cement  
 2 Brass 4 Galvanized steel 6 Concrete tile 8 RMP (SR) 11 Other (specify)  
 9 ABS 12 None used (open hole)  
 SCREEN OR PERFORATION OPENINGS ARE:  
 1 Continuous slot 3 Mill slot 5 Gauzed wrapped ~~XX~~ Saw cut 11 None (open hole)  
 2 Louvered shutter 4 Key punched 6 Wire wrapped 9 Drilled holes  
 7 Torch cut 10 Other (specify)  
 SCREEN-PERFORATED INTERVALS: From ft. to ft., From ft. to ft., From ft. to ft.  
 From 95' ft. to 85' ft., From ft. to ft.  
 GRAVEL PACK INTERVALS: From ft. to ft., From ft. to ft.  
 From 95' ft. to 22' ft., From ft. to ft.

6 GROUT MATERIAL: 1 Neat cement 2 Cement grout ~~XX~~ Bentonite 4 Other  
 Grout Intervals: From 22' ft. to 3' ft., From ft. to ft., From ft. to ft.  
 What is the nearest source of possible contamination:  
 1 Septic tank ~~XX~~ 4 Lateral lines 7 Pit privy 10 Livestock pens 14 Abandoned water well  
 2 Sewer lines 5 Cess pool 8 Sewage lagoon 11 Fuel storage 15 Oil well/Gas well  
 3 Watertight sewer lines 6 Seepage pit 9 Feedyard 12 Fertilizer storage 16 Other (specify below)  
 13 Insecticide storage  
 Direction from well? South How many feet? APP: 2640'

FROM	TO	LITHOLOGIC LOG	FROM	TO	PLUGGING INTERVALS
0'	2'	TOP SOIL.			
2'	9'	Sandy Clay.			
9'	16'	Medium Course Sand.			
16'	27'	Clay.			
27'	40'	Medium Fine Sand.			
40'	43'	Clay.			
43'	56'	Fine Sand.			
56'	59'	Clay.			
59'	67'	Sandy Clay.			
67'	95'	Course SandW/Clay Strips.			
	95'	Red Bed.			

7 CONTRACTOR'S OR LANDOWNER'S CERTIFICATION: This water well was (1) constructed, (2) reconstructed, or (3) plugged under my jurisdiction and was completed on (mo/day/year) May 19 1998 and this record is true to the best of my knowledge and belief. Kansas Water Well Contractor's License No. 112 This Water Well Record was completed on (mo/day/yr) May 31 1998 under the business name of Wells Drilling Co. by (signature) *Dat Wells*