


1 LOCATION OF WATER WELL: Fraction NE 1/4 NW 1/4 SW 1/4 Section Number 26 Township Number T 27 S Range Number R 9 ~~9E~~

Distance and direction from nearest town or city street address of well if located within city?
 7 1/2 Miles West, 1 Mile North, 3/4 Mile West, 3/4 Mile North Of Kingman, Kns.

2 WATER WELL OWNER: Bill Hartley
 RR#, St. Address, Box #: 15381 NW 20th ST.
 City, State, ZIP Code: Cunningham, Kans. 67035
 Board of Agriculture, Division of Water Resources
 Application Number:

3 LOCATE WELL'S LOCATION WITH AN "X" IN SECTION BOX:

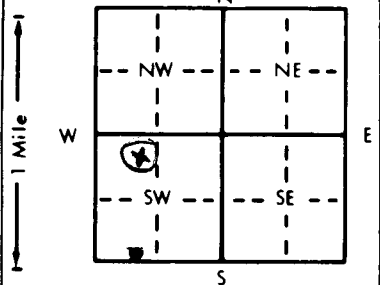

4 DEPTH OF COMPLETED WELL: 103' ft. ELEVATION:
 Depth(s) Groundwater Encountered 1. 40' ft. 2. ft. 3. ft.
 WELL'S STATIC WATER LEVEL: 34' 6" ft. below land surface measured on mo/day/yr Aug. 17, 1998
 Pump test data: Well water was ft. after hours pumping gpm
 Est. Yield: 50 gpm: Well water was ft. after hours pumping gpm
 Bore Hole Diameter: 8 1/4" in. to 103' ft., and in. to ft.
 WELL WATER TO BE USED AS:
 1 Domestic ~~xx~~ 3 Feedlot 6 Oil field water supply 9 Dewatering 12 Other (Specify below)
 2 Irrigation 4 Industrial 7 Lawn and garden only 10 Monitoring well
 Was a chemical/bacteriological sample submitted to Department? Yes No ~~xx~~; If yes, mo/day/yr sample was submitted
 Water Well Disinfected? Yes ~~xx~~ No ~~xx~~

5 TYPE OF BLANK CASING USED:
 1 Steel 3 RMP (SR) 5 Wrought iron 8 Concrete tile CASING JOINTS: Glued ~~xx~~ Clamped
 2 PVC ~~xx~~ 4 ABS 6 Asbestos-Cement 9 Other (specify below) Welded
 7 Fiberglass Threaded
 Blank casing diameter: 5" in. to 93' ft., Dia. in. to ft., Dia. in. to ft.
 Casing height above land surface: 14" in., weight: 2.355 lbs./ft. Wall thickness or gauge No. 2.14

TYPE OF SCREEN OR PERFORATION MATERIAL:
 1 Steel 3 Stainless steel 5 Fiberglass 7 PVC ~~x~~ 10 Asbestos-cement
 2 Brass 4 Galvanized steel 6 Concrete tile 8 RMP (SR) 11 Other (specify)
 12 None used (open hole)
 SCREEN OR PERFORATION OPENINGS ARE:
 1 Continuous slot 3 Mill slot 5 Gauzed wrapped ~~xx~~ Saw cut 11 None (open hole)
 2 Louvered shutter 4 Key punched 6 Wire wrapped 9 Drilled holes
 7 Torch cut 10 Other (specify)
 SCREEN-PERFORATED INTERVALS: From 93' ft. to 103' ft., From ft. to ft.
 From 52' ft. to 60' ft., From ft. to ft.
 GRAVEL PACK INTERVALS: From 103' ft. to 27' ft., From ft. to ft.
 From ft. to ft., From ft. to ft.

6 GROUT MATERIAL: 1 Neat cement 2 Cement grout ~~xx~~ 3 Bentonite 4 Other
 Grout Intervals: From 27' ft. to 3' ft., From ft. to ft., From ft. to ft.
 What is the nearest source of possible contamination:
 1 Septic tank 4 Lateral lines ~~xx~~ 7 Pit privy 10 Livestock pens 14 Abandoned water well
 2 Sewer lines 5 Cess pool 8 Sewage lagoon 11 Fuel storage 15 Oil well/Gas well
 3 Watertight sewer lines 6 Seepage pit 9 Feedyard 12 Fertilizer storage 16 Other (specify below)
 13 Insecticide storage
 Direction from well? South How many feet? APP: 1320'

FROM	TO	LITHOLOGIC LOG	FROM	TO	PLUGGING INTERVALS
0'	2'	Top Soil.			
2'	8'	Medium Course Sand.			
8'	12'	Clay.			
12'	19'	Fine Sandy Clay'.			
19'	23'	Fine Sand.			
23'	29'	Clay.			
29'	40'	Fine Sand.			
40'	50'	Medium Course Sand.			
50'	52'	Clay.			
52'	60'	Medium Course Sand.			
60'	64'	Clay.			
64'	69'	Fine Sand.			
69'	93'	Clay.			
93'	100'	Course Sand. (Clean).			
100'	103'	Red Bad.			

7 CONTRACTOR'S OR LANDOWNER'S CERTIFICATION: This water well was (1) constructed, (2) reconstructed, or (3) plugged under my jurisdiction and was completed on (mo/day/year) Aug. 17, 1998 and this record is true to the best of my knowledge and belief. Kansas Water Well Contractor's License No. 112 This Water Well Record was completed on (mo/day/yr) AUG. 29, 1998 under the business name of Wells Drilling Co by (signature) Dal Wells

OFFICE USE ONLY
T
R
EW
SEC.
1/4
1/4
1/4