MW-102

WATER WELL RECORD Form WWC-5 KSA 82a-1212 SE 115 BA MWeep

1 LOCATION OF WATER WELL: County: Sedgwick	Fraction: NE ¼ NE ¼ NE ¼	Section Number: 2	Township Number: T 28 S	Range Number: R 1 E (W)

Distance and direction from nearest town or city street address of well if located within city?
east of the northeast corner of the bldg w/address 4105 W. Pawnee Wichita, ks

2 WATER WELL OWNER: NCR
RR#, St. Address, Box # : ECD-2, 101 W. Shantz Avenue
City, State, ZIP Code : Dayton, OH 45479

Board of Agriculture, Division of Water Resource
Application Number:

3 LOCATE WELL'S LOCATION WITH AN "X" IN SECTION BOX:

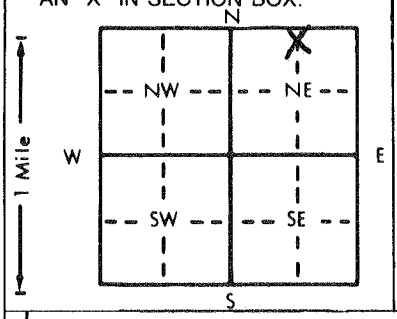

4 DEPTH OF COMPLETED WELL 20.5 ft. ELEVATION: 1274.86 ft (MSL)
Depth(s) Groundwater Encountered 1. 12.7 ft. 2. ft. 3. ft.
WELL'S STATIC WATER LEVEL 12.7 ft. below land surface measured on mo/day/yr 2/28/96
Pump test data: Well water was ft. after hours pumping 1/3 gpm
Est. Yield 45 gpm: Well water was ft. after hours pumping gpm
Bore Hole Diameter 7 7/8 in. to 20.5 ft., and 4.0 in. to 25.0 ft.
WELL WATER TO BE USED AS: 5 Public water supply 8 Air conditioning 11 Injection well
1 Domestic 3 Feedlot 6 Oil field water supply 9 Dewatering 12 Other (Specify below)
2 Irrigation 4 Industrial 7 Lawn and garden only (10) Monitoring well
Was a chemical/bacteriological sample submitted to Department? (Yes) No; If yes, mo/day/yr sample was submitted 2/29/96
Water Well Disinfected? Yes (No)

5 TYPE OF BLANK CASING USED: 5 Wrought iron 8 Concrete tile CASING JOINTS: Glued Clamped
1 Steel 3 RMP (SR) 6 Asbestos-Cement 9 Other (specify below) Welded
(2) PVC 4 ABS 7 Fiberglass (Threaded)
Blank casing diameter 2.0 in. to 10.0 ft., Dia in. to ft., Dia in. to ft.
Casing height above land surface in., weight lbs./ft. Wall thickness or gauge No. Schedule 40
TYPE OF SCREEN OR PERFORATION MATERIAL: (7) PVC 10 Asbestos-cement
1 Steel 3 Stainless steel 5 Fiberglass 8 RMP (SR) 11 Other (specify)
2 Brass 4 Galvanized steel 6 Concrete tile 9 ABS 12 None used (open hole)
SCREEN OR PERFORATION OPENINGS ARE: 5 Gauzed wrapped 8 Saw cut 11 None (open hole)
1 Continuous slot (3) Mill slot 6 Wire wrapped 9 Drilled holes
2 Louvered shutter 4 Key punched 7 Torch cut 10 Other (specify)
SCREEN-PERFORATED INTERVALS: From 10.0 ft. to 20.0 ft., From ft. to ft
From ft. to ft., From ft. to ft
GRAVEL PACK INTERVALS: From 8.0 ft. to 25.0 ft., From ft. to ft
From ft. to ft., From ft. to ft

6 GROUT MATERIAL: 1 Neat cement 2 Cement grout (3) Bentonite 4 Other
Grout Intervals: From 5.0 ft. to 8.0 ft., From ft. to ft., From ft. to ft
What is the nearest source of possible contamination: 10 Livestock pens 14 Abandoned water well
1 Septic tank 4 Lateral lines 7 Pit privy 11 Fuel storage 15 Oil well/Gas well
2 Sewer lines 5 Cess pool 8 Sewage lagoon 12 Fertilizer storage (16) Other (specify below) BA
3 Watertight sewer lines (6) Seepage pit 9 Feedyard 13 Insecticide storage ~~Unknown. This is a side gradient well~~
Direction from well? Southeast How many feet? 230

FROM	TO	LITHOLOGIC LOG	FROM	TO	PLUGGING INTERVALS
0	1.0	brown, dry, low plastic silty CLAY (CL)			
1.0	4.0	dark brown, medium dense very fine sand			
4.0	13.0	becoming yellowish brown, moist			
13.0	20.5	becoming wet			
20.5	25.0	dark grey, wet, high plastic silty CLAY			

7 CONTRACTOR'S OR LANDOWNER'S CERTIFICATION: This water well was (1) constructed, (2) reconstructed, or (3) plugged under my jurisdiction and was completed on (mo/day/year) 2/27/96 and this record is true to the best of my knowledge and belief. Kansas Water Well Contractor's License No. 399 This Water Well Record was completed on (mo/day/yr) 3-26-96 under the business name of WOODWARD-CLYDE CONSULTANTS by (signature) Richard K. Mitchell

INSTRUCTIONS: Use typewriter or ball point pen. *PLEASE PRESS FIRMLY* and *PRINT* clearly. Please fill in blanks, underline or circle the correct answers. Send top three copies to Kansas Department of Health and Environment, Bureau of Water, Topeka, Kansas 66620-0001. Telephone: 913-296-5545. Send one to WATER WELL OWNER and retain one for your records.