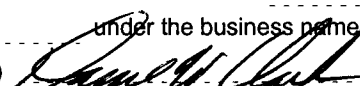


1	LOCATION OF WATER WELL:	Fraction	Section	Number	Township	Number	Range	Number																											
	County: Sedgwick	NW 1/4 NW 1/4 NW 1/4	35		T	28	S	R 1 E W																											
Distance and direction from nearest town or city street address of well if located within city? Approximately 2 miles west of Haysville																																			
2	WATER WELL OWNER: Vulcan Materials Company RR#, St. Address, Box # P.O. Box 12283 City, State, ZIP Code Wichita, KS 67277 Board of Agriculture, Division of Water Resources Application Number: _____																																		
3	MARK WELL'S LOCATION WITH AN "X" IN SECTION BOX: N E W E S E NW NE SW SE X		4 DEPTH OF WELL 62 ft WELL'S STATIC WATER LEVEL 39.85 ft. WELL WAS USED AS: 1 Domestic 5 Public Water Supply 9 Dewatering 2 Irrigation 6 Oil Field Water Supply 10 Monitoring Well 3 Feedlot 7 Domestic (Lawn & Garden) 11 Injection Well 4 Industrial 8 Air Conditioning 12 Other Was a chemical / bacteriological sample submitted to Department? Yes _____ No ☒ If yes, mo/day/yr sample was submitted _____ Water Well Disinfected: Yes ☒ No _____																																
5	TYPE OF BLANK CASING USED: 1 Steel 3 RMP (SR) 5 Wrought 7 Fiberglass 9 Other (Specify below) 2 PVC 4 ABS 6 Asbestos-Cement 8 Concrete Tile Blank casing diameter 5 in. Was casing pulled? Yes _____ No ☒ Casing height above or below land surface 48 in. If yes, how much Cut off																																		
6	GROUT PLUG MATERIAL: 1 Neat Cement 2 Cement grout 3 Bentonite 4 Other Bentonite Holeplug Grout Plug Intervals: From _____ ft. to _____ ft., From _____ ft. to _____ ft. From 62 ft. to 4 ft. What is the nearest source of possible contamination: 1 Septic tank 6 Seepage pit 11 Fuel storage 16 Other (specify below) 2 Sewer lines 7 Pit privy 12 Fertilizer storage None known 3 Watertight sewer lines 8 Sewage lagoon 13 Insecticide storage 4 Lateral lines 9 Feedyard 14 Abandoned water well 5 Cess Pool 10 Livestock pens 15 Oil well/Gas well Direction from well? _____ How many feet? _____																																		
<table border="1" style="width:100%; border-collapse: collapse;"> <thead> <tr> <th style="width:10%;">FROM</th> <th style="width:10%;">TO</th> <th style="width:80%;">PLUGGING MATERIALS</th> </tr> </thead> <tbody> <tr> <td style="text-align: center;">62</td> <td style="text-align: center;">4</td> <td>Bentonite Holeplug</td> </tr> <tr> <td style="text-align: center;">4</td> <td style="text-align: center;">0</td> <td>Soil</td> </tr> <tr><td> </td><td> </td><td> </td></tr> <tr><td> </td><td> </td><td> </td></tr> <tr><td> </td><td> </td><td> </td></tr> <tr><td> </td><td> </td><td> </td></tr> <tr><td> </td><td> </td><td> </td></tr> <tr><td> </td><td> </td><td> </td></tr> </tbody> </table>									FROM	TO	PLUGGING MATERIALS	62	4	Bentonite Holeplug	4	0	Soil																		
FROM	TO	PLUGGING MATERIALS																																	
62	4	Bentonite Holeplug																																	
4	0	Soil																																	
7	CONTRACTOR'S OR LANDOWNER'S CERTIFICATION: This water well was plugged under my jurisdiction and was completed on (mo/day/year) 7-9-01 and this record is true to the best of my knowledge and belief. Kansas Water Well Contractor's License No. 185 This Water Well Record was completed on (mo/day/year) 7-27-01 by (signature)  under the business name of Clarke Well & Equipment, Inc.																																		
INSTRUCTIONS: Use typewriter or ball point pen. Please press firmly and print clearly. Please fill in blanks, underline or circle the correct answers. Send top three copies to Kansas Department of Health & Environment, Bureau of Water, Topeka, Kansas 66620-0001. Telephone: 785/296-3565. Send one to Water Well Owner and retain one for your records.																																			