5717 WATER WELL PLUGGING RECORD Form WWC-5P KSA82a-1212 ID NO. _____

1 LOCATION OF WATER WELL:	Fraction	Section Number	Township Number	Range Number
County: Sedgwick	NW 1/4 NE 1/4 NW 1/4	35	T 28 S	R 1 E (W)

Distance and direction from nearest town or city street address of well if located within city?
Approximately 1 3/4 miles west of Haysville

2 WATER WELL OWNER: Vulcan Materials Company
RR#, St. Address, Box # P.O. Box 12283
City, State, ZIP Code Wichita, KS 67277
Board of Agriculture, Division of Water Resources Application Number:

3 MARK WELL'S LOCATION WITH AN "X" IN SECTION BOX:

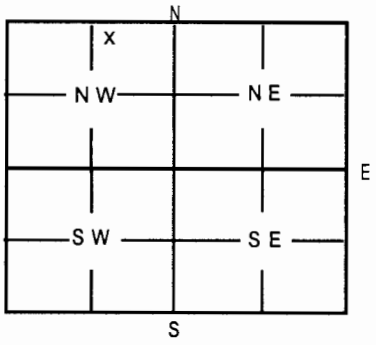

4 DEPTH OF WELL 50.78 ft
WELL'S STATIC WATER LEVEL 37.18 ft.
WELL WAS USED AS:

(1) Domestic	5 Public Water Supply	9 Dewatering
2 Irrigation	6 Oil Field Water Supply	10 Monitoring Well
3 Feedlot	7 Domestic (Lawn & Garden)	11 Injection Well
4 Industrial	8 Air Conditioning	12 Other

Was a chemical / bacteriological sample submitted to Department? Yes ___ No ✓
If yes, mo/day/yr sample was submitted ___
Water Well Disinfected: Yes ✓ No ___

5 TYPE OF BLANK CASING USED:

1 Steel	3 RMP (SR)	5 Wrought	7 Fiberglass	9 Other (Specify below)
(2 PVC)	4 ABS	6 Asbestos-Cement	8 Concrete Tile	

Blank casing diameter 5 in. Was casing pulled? Yes ___ No ✓ If yes, how much Cut off
Casing height above or (below) land surface 48 in.

6 GROUT PLUG MATERIAL: 1 Neat Cement 2 Cement grout 3 Bentonite 4 Other Bentonite Holeplug
Grout Plug Intervals: From ___ ft. to ___ ft., From ___ ft. to ___ ft. From 50.78 ft. to 4 ft.
What is the nearest source of possible contamination:

1 Septic tank	6 Seepage pit	11 Fuel storage	16 Other (specify below)
2 Sewer lines	7 Pit privy	12 Fertilizer storage	None known
3 Watertight sewer lines	8 Sewage lagoon	13 Insecticide storage	
4 Lateral lines	9 Feedyard	14 Abandoned water well	
5 Cess Pool	10 Livestock pens	15 Oil well/Gas well	

Direction from well? ___ How many feet? ___

FROM	TO	PLUGGING MATERIALS
50.78	4	Bentonite Holeplug
4	0	Soil

7 CONTRACTOR'S OR LANDOWNER'S CERTIFICATION: This water well was plugged under my jurisdiction and was completed on (mo/day/year) 7-9-01 and this record is true to the best of my knowledge and belief. Kansas Water Well Contractor's License No. 185 This Water Well Record was completed on (mo/day/year) 7-27-01 under the business name of Clarke Well & Equipment, Inc.
by (signature) [signature]

INSTRUCTIONS: Use typewriter or ball point pen. Please press firmly and print clearly. Please fill in blanks, underline or circle the correct answers. Send top three copies to Kansas Department of Health & Environment, Bureau of Water, Topeka, Kansas 66620-0001. Telephone: 785/296-3565. Send one to Water Well Owner and retain one for your records.