WATER WELL PLUGGING RECORD Form WWC-5P KSA 82a-1212 ID NO. MW-2

1 LOCATION OF WATER WELL:	Fraction	Section Number	Township Number	Range Number
County: Sedgwick	SE¼ NW¼ SW ¼	1	28S	01W

Distance and direction from nearest town or city street address of well if located within city?
3737 W. 29th St. South, Wichita

2 WATER WELL OWNER: Autry Enterprises, Inc.
RR #, St. Address, Box #: 3737 W. 29th St. South
City, State, ZIP Code : Wichita, KS 67217
Board of Agriculture, Division of Water Resources
Application Number:

3 MARK WELL'S LOCATION WITH AN "X" IN SECTION BOX:

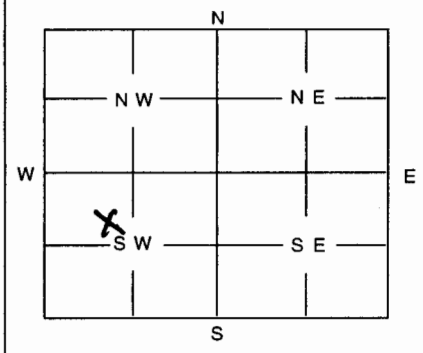

4 DEPTH OF WELL 20 ft
WELL'S STATIC WATER LEVEL 11.55 ft.

WELL WAS USED AS:

1 Domestic	5 Public Water Supply	9 Dewatering
2 Irrigation	6 Oil Field Water Supply	(10) Monitoring Well
3 Feedlot	7 Domestic (Lawn & Garden)	11 Injection Well
4 Industrial	8 Air Conditioning	12 Other

Was a chemical / bacteriological sample submitted to Department? Yes ..... No X
If yes, mo/day/yr sample was submitted NA
Water Well Disinfected: Yes ..... No X

5 TYPE OF BLANK CASING USED:

1 Steel	3 RMP (SR)	5 Wrought	7 Fiberglass	9 Other (Specify below)	
(2) PVC	4 ABS	6 Asbestos-Cement	8 Concrete Tile		

Blank casing diameter 2 in. Was casing pulled? Yes X No ..... If yes, how much 20'
Casing height above or (below) land surface 0.69ft. in.

6 GROUT PLUG MATERIAL: 1 Neat cement 2 Cement grout (3) Bentonite 4 Other .....
Grout Plug Intervals: From 20 ft. to 2 ft., From ..... ft. to ..... ft., From ..... to ..... ft.

What is the nearest source of possible contamination:

1 Septic tank	6 Seepage pit	(11) Fuel storage	16 Other (specify below)
2 Sewer lines	7 Pit privy	12 Fertilizer storage	
3 Watertight sewer lines	8 Sewage lagoon	13 Insecticide storage	
4 Lateral lines	9 Feedyard	14 Abandoned water well	
5 Cess Pool	10 Livestock pens	15 Oil well/Gas well	

Direction from well? NW How many feet? 90

FROM	TO	PLUGGING MATERIALS
0	2	Native Material + Pavement
2	20	Chip bentonite - hydrated

* Per conversation w/ Don Taylor (BOW), pulled casing, filled void with bentonite. No overdrilling due to inaccessibility.

RECEIVED
NOV 17 2004
BUREAU OF WATER

7 CONTRACTOR'S OR LANDOWNER'S CERTIFICATION: This water well was plugged under my jurisdiction and was completed on (mo/day/year) 10/27/04 and this record is true to the best of my knowledge and belief. Kansas Water Well Contractor's License No. 650 This Water Well Record was completed on (mo/day/year) 10/27/04 under the business name of Deffenbaugh Field Services by (signature)

INSTRUCTIONS: Use typewriter or ball point pen. Please press firmly and print clearly. Please fill in blanks, underline or circle the correct answers. Send top three copies to Kansas Department of Health and Environment, Bureau of Water, Topeka, Kansas 66620-0001. Telephone: 785/296-3565. Send one to Water Well Owner and retain one for your records.