


1 LOCATION OF WATER WELL: County: <u>Sedgewick</u> Fraction: <u>NE 1/4 NW 1/4 SW 1/4</u> Section Number: <u>14</u> Township Number: <u>T 28 S</u> Range Number: <u>R 1 E</u> <u>W</u>

Distance and direction from nearest town or city street address of well if located within city?

5222 W. 44th Ct. S.

2 WATER WELL OWNER: <u>Mike Sweaney</u> RR#, St. Address, Box #: <u>5222 W. 44th Ct. S.</u> City, State, ZIP Code: <u>Wichita, KS 67217</u>	Board of Agriculture, Division of Water Resources Application Number:
---	--

3 LOCATE WELL'S LOCATION WITH AN "X" IN SECTION BOX:	4 DEPTH OF COMPLETED WELL <u>62'</u> ft. ELEVATION:
--	---

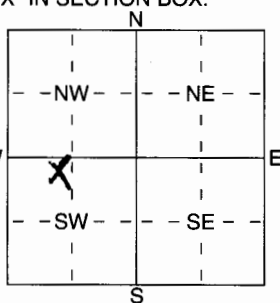

Depth(s) Groundwater Encountered 1..... ft. 2..... ft. 3..... ft.

WELL'S STATIC WATER LEVEL 24 ft. below land surface measured on mo/day/yr

Pump test data: Well water was ft. after hours pumping gpm

Est. Yield 40 gpm: Well water was ft. after hours pumping gpm

WELL WATER TO BE USED AS: 5 Public water supply 8 Air conditioning 11 Injection well

1 Domestic 3 Feedlot 6 Oil field water supply 9 Dewatering 12 Other (Specify below)

2 Irrigation 4 Industrial 7 Domestic (lawn & garden) 10 Monitoring wellWas a chemical/bacteriological sample submitted to Department? Yes No X; If yes, mo/day/yr sample was submitted
Water Well Disinfected? Yes X No

5 TYPE OF BLANK CASING USED:	5 Wrought iron	8 Concrete tile	CASING JOINTS: Glued <u>X</u> Clamped
------------------------------	----------------	-----------------	---------------------------------------

1 Steel 3 RMP (SR) 6 Asbestos-Cement 9 Other (specify below) Welded

2 PVC 4 ABS 7 Fiberglass ThreadedBlank casing diameter 5" in. to 52 ft., Dia in. to ft., Dia in. to ft.Casing height above land surface 12" in., weight 2.14 lbs./ft. Wall thickness or gauge No. 160 PSI

TYPE OF SCREEN OR PERFORATION MATERIAL:

1 Steel 3 Stainless Steel 5 Fiberglass 8 RMP (SR) 10 Asbestos-Cement

2 Brass 4 Galvanized Steel 6 Concrete tile 9 ABS 11 Other (Specify) 12 None used (open hole)

SCREEN OR PERFORATION OPENINGS ARE:

1 Continuous slot 3 Mill slot 5 Guazed wrapped 8 Saw cut 11 None (open hole)

2 Louvered shutter 4 Key punched 6 Wire wrapped 9 Drilled holes 10 Other (specify) ft.

SCREEN-PERFORATED INTERVALS: From 52 ft. to 62 ft., From ft. to ft.

From ft. to ft., From ft. to ft.

GRAVEL PACK INTERVALS: From 24 ft. to 62 ft., From ft. to ft.

From ft. to ft., From ft. to ft.

6 GROUT MATERIAL:	1 Neat cement	2 Cement grout	<u>3</u> Bentonite	4 Other
-------------------	---------------	----------------	--------------------	---------

Grout Intervals: From 1 ft. to 24 ft., From ft. to ft., From ft. to ft.

What is the nearest source of possible contamination:

1 Septic tank 4 Lateral lines 7 Pit privy 10 Livestock pens 14 Abandoned water well

2 Sewer lines 5 Cess pool 8 Sewage lagoon 11 Fuel storage 15 Oil well/Gas well

3 Watertight sewer lines 6 Seepage pit 9 Feedyard 12 Fertilizer storage 16 Other (specify below)Direction from well? East How many feet? 18'

FROM TO LITHOLOGIC LOG FROM TO PLUGGING INTERVALS

0 3 Top Soil

3 24 Clay

24 44 Fine Sand

44 62 Med Sand

7 CONTRACTOR'S OR LANDOWNER'S CERTIFICATION: This water well was (1) constructed, (2) reconstructed, or (3) plugged under my jurisdiction and wascompleted on (mo/day/year) 4-20-05 and this record is true to the best of my knowledge and belief. KansasWater Well Contractor's Licence No 2740 This Water Well Record was completed on (mo/day/yr) 5-5-07under the business name of Worshiper Drilling Inc. by (signature) [Signature]