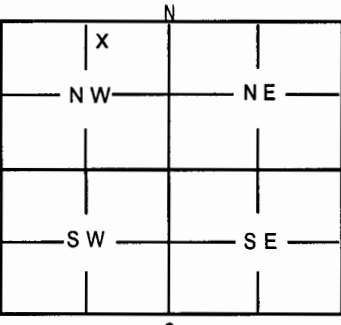
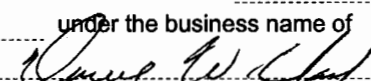


1	LOCATION OF WATER WELL: County: Sedgwick	Fraction NW 1/4 NE 1/4 NW 1/4	Section Number 34	Township Number T 28 S	Range Number R 1 E	W																											
Distance and direction from nearest town or city street address of well if located within city? Approximately 2 3/4 mile west of Haysville																																	
2	WATER WELL OWNER: Vulcan Materials Company RR#, St. Address, Box # P.O. Box 12283 City, State, ZIP Code Wichita, KS 67277 Board of Agriculture, Division of Water Resources Application Number:																																
3	MARK WELL'S LOCATION WITH AN "X" IN SECTION BOX: 		4 DEPTH OF WELL 93.60 ft WELL'S STATIC WATER LEVEL 57 ft. WELL WAS USED AS: <table style="width:100%; border: none;"> <tr> <td style="width:33%;">1 Domestic</td> <td style="width:33%;">5 Public Water Supply</td> <td style="width:33%;">9 Dewatering</td> </tr> <tr> <td>2 Irrigation</td> <td>6 Oil Field Water Supply</td> <td>10 Monitoring Well</td> </tr> <tr> <td>3 Feedlot</td> <td>7 Domestic (Lawn & Garden)</td> <td>11 Injection Well</td> </tr> <tr> <td>4 Industrial</td> <td>8 Air Conditioning</td> <td>12 Other</td> </tr> </table> Was a chemical / bacteriological sample submitted to Department? Yes _____ No ☒ If yes, mo/day/yr sample was submitted _____ Water Well Disinfected: Yes ☒ No _____				1 Domestic	5 Public Water Supply	9 Dewatering	2 Irrigation	6 Oil Field Water Supply	10 Monitoring Well	3 Feedlot	7 Domestic (Lawn & Garden)	11 Injection Well	4 Industrial	8 Air Conditioning	12 Other															
1 Domestic	5 Public Water Supply	9 Dewatering																															
2 Irrigation	6 Oil Field Water Supply	10 Monitoring Well																															
3 Feedlot	7 Domestic (Lawn & Garden)	11 Injection Well																															
4 Industrial	8 Air Conditioning	12 Other																															
5	TYPE OF BLANK CASING USED: <table style="width:100%; border: none;"> <tr> <td style="width:16.6%;">1 Steel</td> <td style="width:16.6%;">3 RMP (SR)</td> <td style="width:16.6%;">5 Wrought</td> <td style="width:16.6%;">7 Fiberglass</td> <td style="width:16.6%;">9 Other (Specify below)</td> </tr> <tr> <td>2 PVC</td> <td>4 ABS</td> <td>6 Asbestos-Cement</td> <td>8 Concrete Tile</td> <td></td> </tr> </table> Blank casing diameter 6 in. Was casing pulled? Yes _____ No ☒ Casing height above or below land surface 48 in. If yes, how much Cut off						1 Steel	3 RMP (SR)	5 Wrought	7 Fiberglass	9 Other (Specify below)	2 PVC	4 ABS	6 Asbestos-Cement	8 Concrete Tile																		
1 Steel	3 RMP (SR)	5 Wrought	7 Fiberglass	9 Other (Specify below)																													
2 PVC	4 ABS	6 Asbestos-Cement	8 Concrete Tile																														
6	GROUT PLUG MATERIAL: 1 Neat Cement 2 Cement grout 3 Bentonite 4 Other Bentonite Holeplug Grout Plug Intervals: From _____ ft. to _____ ft., From _____ ft. to _____ ft. From 93.60 ft. to 4 ft. What is the nearest source of possible contamination: <table style="width:100%; border: none;"> <tr> <td style="width:33%;">1 Septic tank</td> <td style="width:33%;">6 Seepage pit</td> <td style="width:33%;">11 Fuel storage</td> </tr> <tr> <td>2 Sewer lines</td> <td>7 Pit privy</td> <td>12 Fertilizer storage</td> </tr> <tr> <td>3 Watertight sewer lines</td> <td>8 Sewage lagoon</td> <td>13 Insecticide storage</td> </tr> <tr> <td>4 Lateral lines</td> <td>9 Feedyard</td> <td>14 Abandoned water well</td> </tr> <tr> <td>5 Cess Pool</td> <td>10 Livestock pens</td> <td>15 Oil well/Gas well</td> </tr> <tr> <td colspan="3">16 Other (specify below) Monitor Well</td> </tr> </table> Direction from well? Northwest How many feet? 36						1 Septic tank	6 Seepage pit	11 Fuel storage	2 Sewer lines	7 Pit privy	12 Fertilizer storage	3 Watertight sewer lines	8 Sewage lagoon	13 Insecticide storage	4 Lateral lines	9 Feedyard	14 Abandoned water well	5 Cess Pool	10 Livestock pens	15 Oil well/Gas well	16 Other (specify below) Monitor Well											
1 Septic tank	6 Seepage pit	11 Fuel storage																															
2 Sewer lines	7 Pit privy	12 Fertilizer storage																															
3 Watertight sewer lines	8 Sewage lagoon	13 Insecticide storage																															
4 Lateral lines	9 Feedyard	14 Abandoned water well																															
5 Cess Pool	10 Livestock pens	15 Oil well/Gas well																															
16 Other (specify below) Monitor Well																																	
<table border="1" style="width:100%; border-collapse: collapse;"> <thead> <tr> <th style="width:10%;">FROM</th> <th style="width:10%;">TO</th> <th style="width:80%;">PLUGGING MATERIALS</th> </tr> </thead> <tbody> <tr> <td style="text-align: center;">93.60</td> <td style="text-align: center;">4</td> <td>Bentonite Holeplug</td> </tr> <tr> <td style="text-align: center;">4</td> <td style="text-align: center;">0</td> <td>Compacted Soil</td> </tr> <tr><td> </td><td> </td><td> </td></tr> <tr><td> </td><td> </td><td> </td></tr> <tr><td> </td><td> </td><td> </td></tr> <tr><td> </td><td> </td><td> </td></tr> <tr><td> </td><td> </td><td> </td></tr> <tr><td> </td><td> </td><td> </td></tr> </tbody> </table>							FROM	TO	PLUGGING MATERIALS	93.60	4	Bentonite Holeplug	4	0	Compacted Soil																		
FROM	TO	PLUGGING MATERIALS																															
93.60	4	Bentonite Holeplug																															
4	0	Compacted Soil																															
7	CONTRACTOR'S OR LANDOWNER'S CERTIFICATION: This water well was plugged under my jurisdiction and was completed on (mo/day/year) 6-1-05 and this record is true to the best of my knowledge and belief. Kansas Water Well Contractor's License No. 185 This Water Well Record was completed on (mo/day/year) 6-8-05 under the business name of Clarke Well & Equipment, Inc. by (signature) 																																
INSTRUCTIONS: Use typewriter or ball point pen. Please press firmly and print clearly. Please fill in blanks, underline or circle the correct answers. Send top three copies to Kansas Department of Health & Environment, Bureau of Water, Topeka, Kansas 66620-0001. Telephone: 785/296-3565. Send one to Water Well Owner and retain one for your records.																																	